


T. 9 S., R. 4 W., W.M.

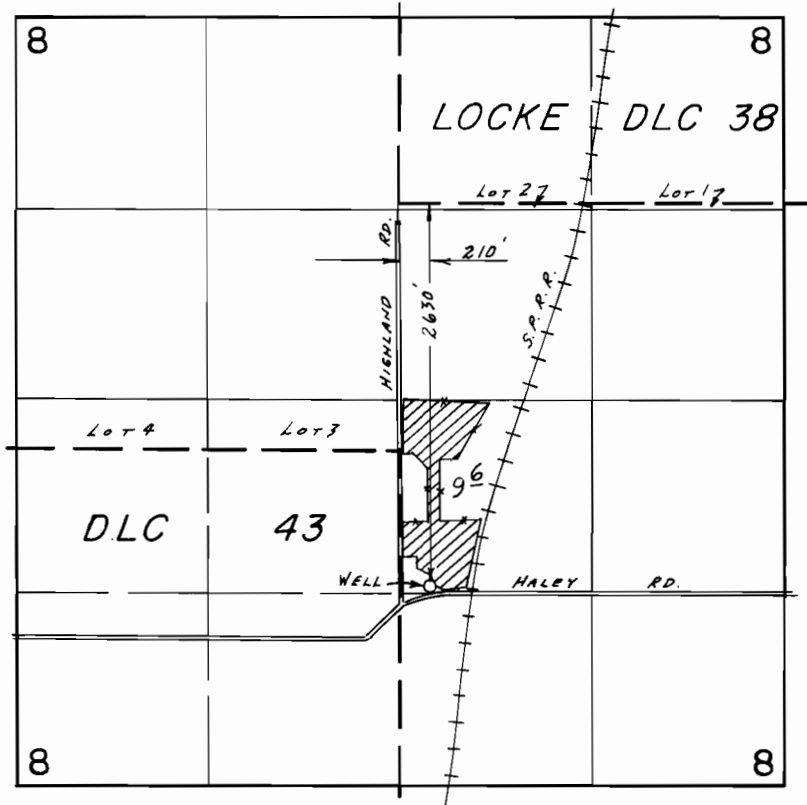

SCALE : 1" = 1320'

FINAL PROOF SURVEY
UNDER

Application No. G-11049 Permit No. G-10208...
IN NAME OF

HIGHLAND TREE FARMS, INCORPORATED

Surveyed June 29, 1987, by B.W. BISHOP...

3/28/89

PTS 1987-3

BWB