


T12S, R2W, WM

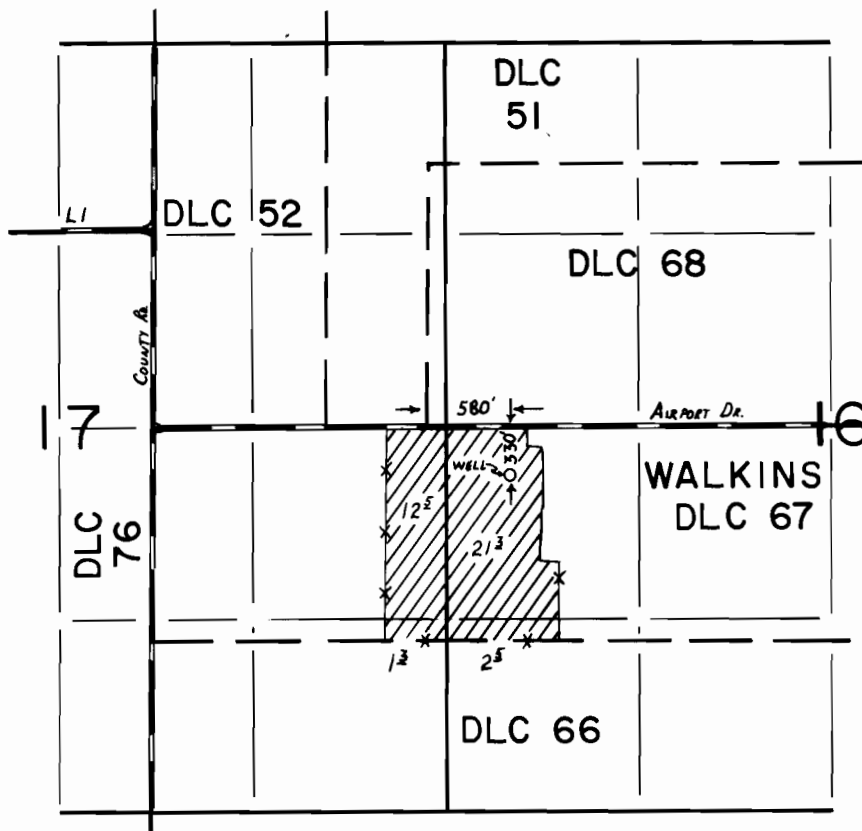

FINAL PROOF SURVEY UNDER

Application No. G-11398 Permit No. G-10513...
IN NAME OF

.....SYLVESTER J. FREY.....

Surveyed SEPT. 12, 1988, by T. M. WARREN...