


T.16S. R.7W. W.M.

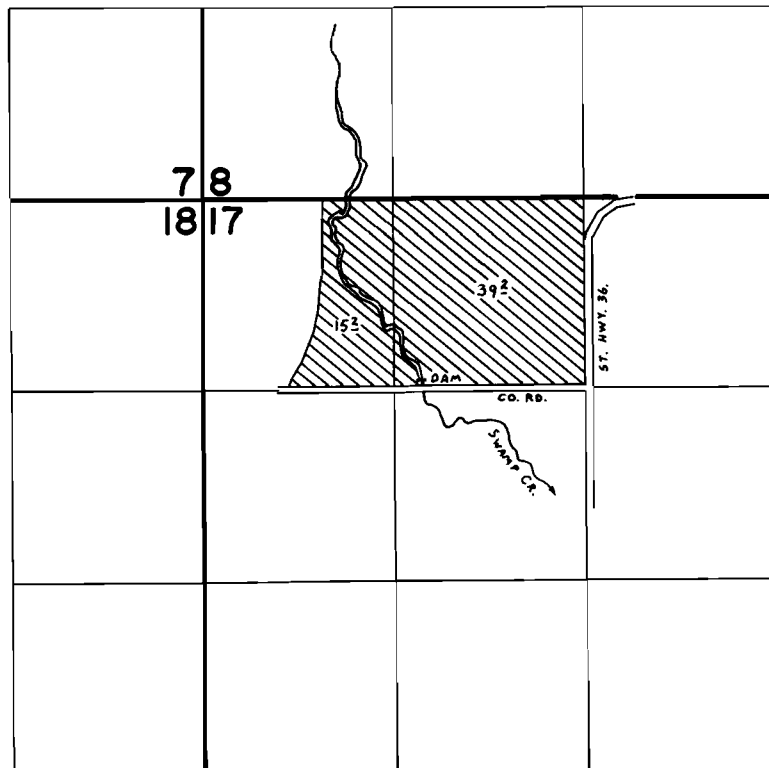

DAM LOC: 1250'S. & 1500'E. fr. N.W. Cor. SEC. 17.

**FINAL PROOF SURVEY**  
UNDER

R-49804                      R-6134  
Application No. 49805 Permit No. 37925.....  
IN NAME OF

JEAN C. CACAN

Surveyed June 20, 1979, by C. L. HUGHES.....