


T. 36 S., R. 4 W., W.M.

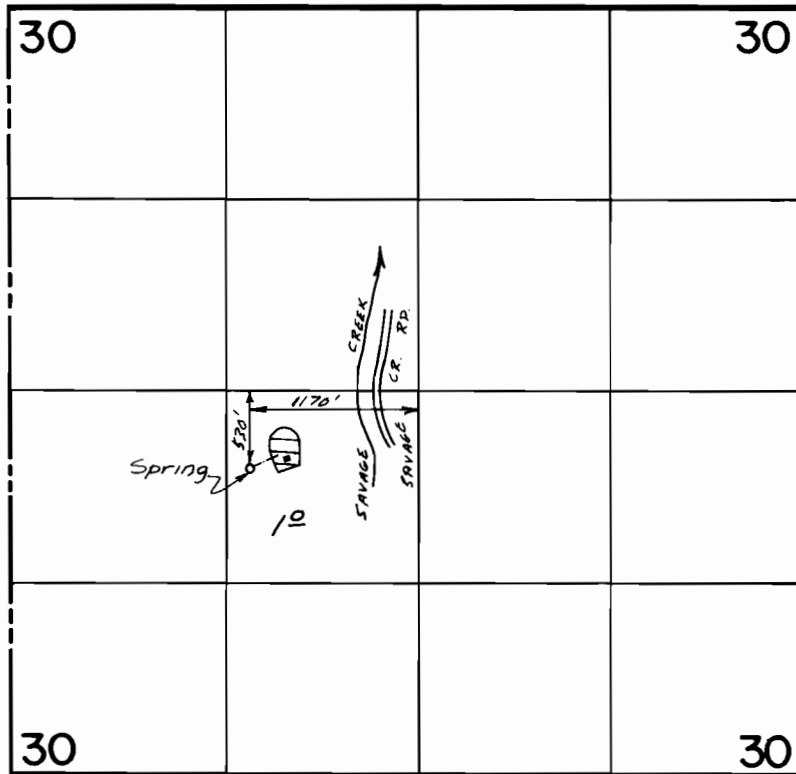

Scale 1" = 1320'

FINAL PROOF SURVEY UNDER

Application No. 50896 Permit No. 38427.....
IN NAME OF

.....JUANITA PEDEN.....

Surveyed Oct. 16 1986, by BS. JAMES.....
April 6, 1987