


T.29S., R.6W., W.M.

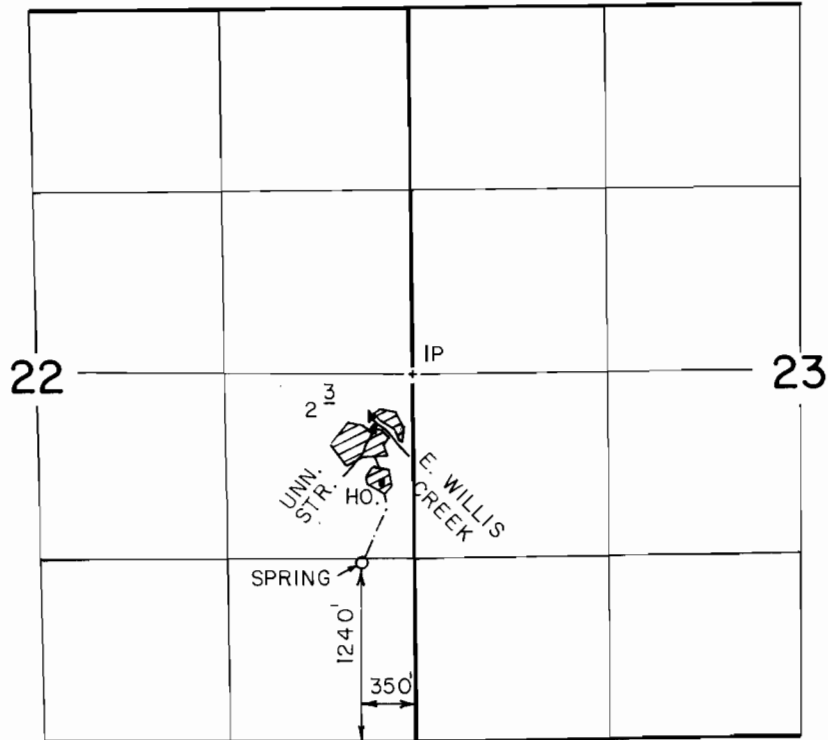

SCALE: 4" = 1mile

FINAL PROOF SURVEY
UNDER

Application No. 51790... Permit No. 39944.....
IN NAME OF

.....**PAUL SANADA**.....

Surveyed JULY 11, 1984, by *J.E. Cashion*.....