


T. 34 S., R. 2 W., W. M.

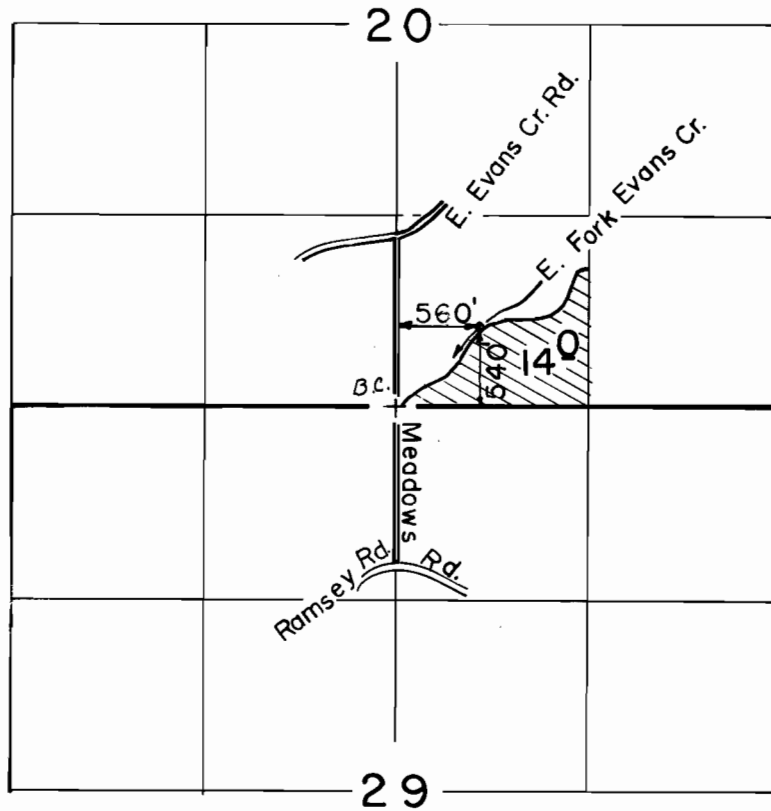

Scale:
1" = 1320'

FINAL PROOF SURVEY
UNDER

Application No. 51813... Permit No. 39023...
IN NAME OF

.....WAYNE E. REGULA.....

Surveyed JUN. 10. 19.87., by B. S. JAMES..