


T. 34 S., R. 3 W., W. M.

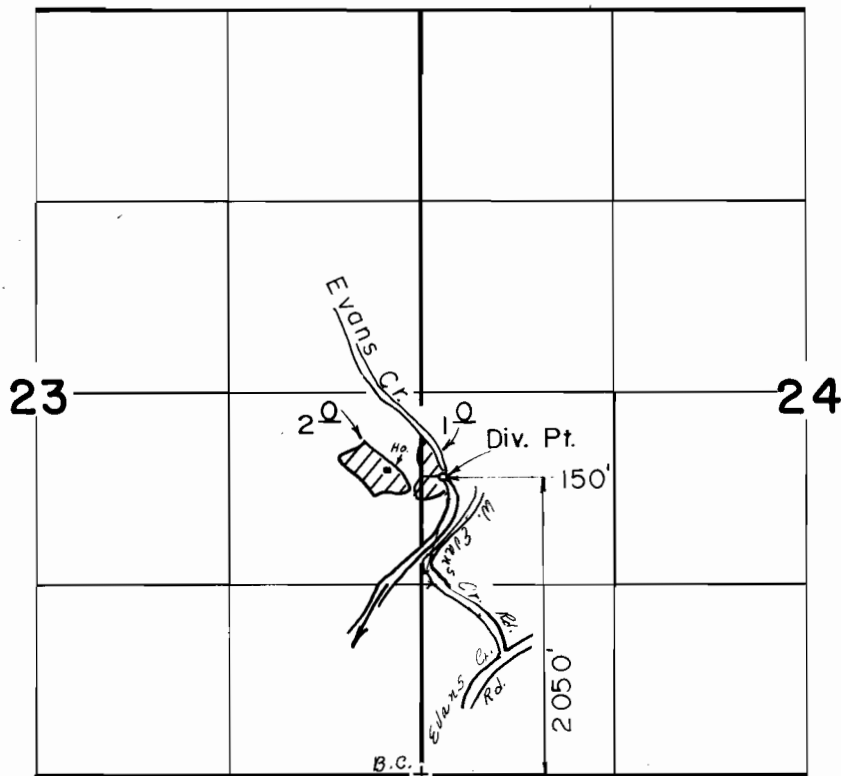

Scale: 1" = 1320'

**FINAL PROOF SURVEY**  
UNDER

Application No. 52437 Permit No. 39438...  
IN NAME OF

.....WILLIAM G. MC GAHEY.....

Surveyed JUL. 23. 19.87, by B. S. JAMES.....