


T. 21S., R. 5W., W. M.
SECTIONS 27 & 28

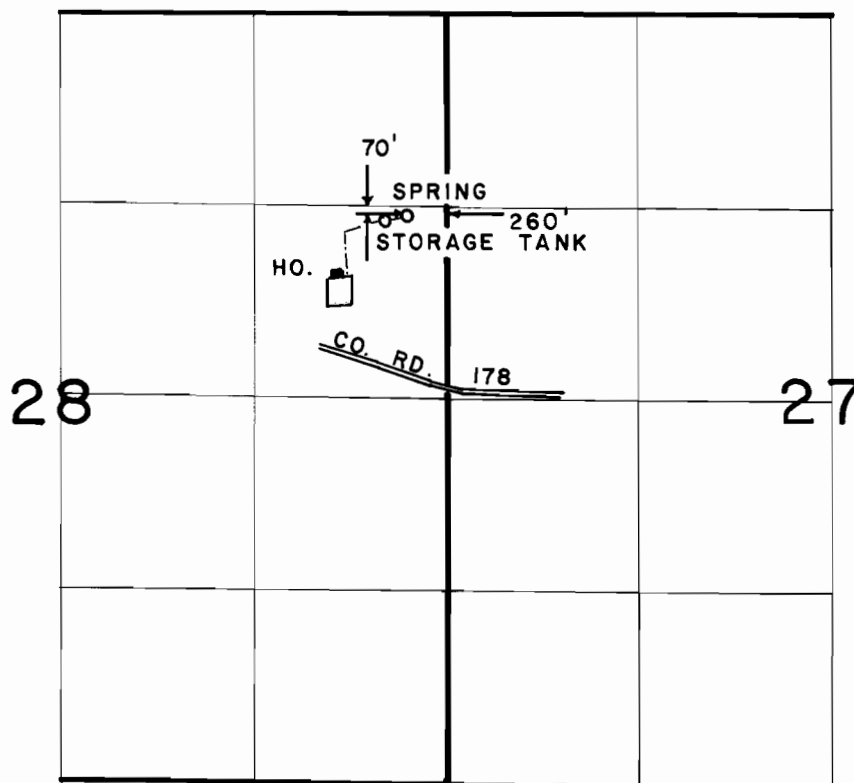

SCALE: 4" = 1 MILE

FINAL PROOF SURVEY
UNDER

Application No. 53157 Permit No. 38784
IN NAME OF

EUGENE D. RADEKA

Surveyed OCT. 8 1987, by J. M. SCHMORDE