


T. 37 S., R. 3 W., W.M.

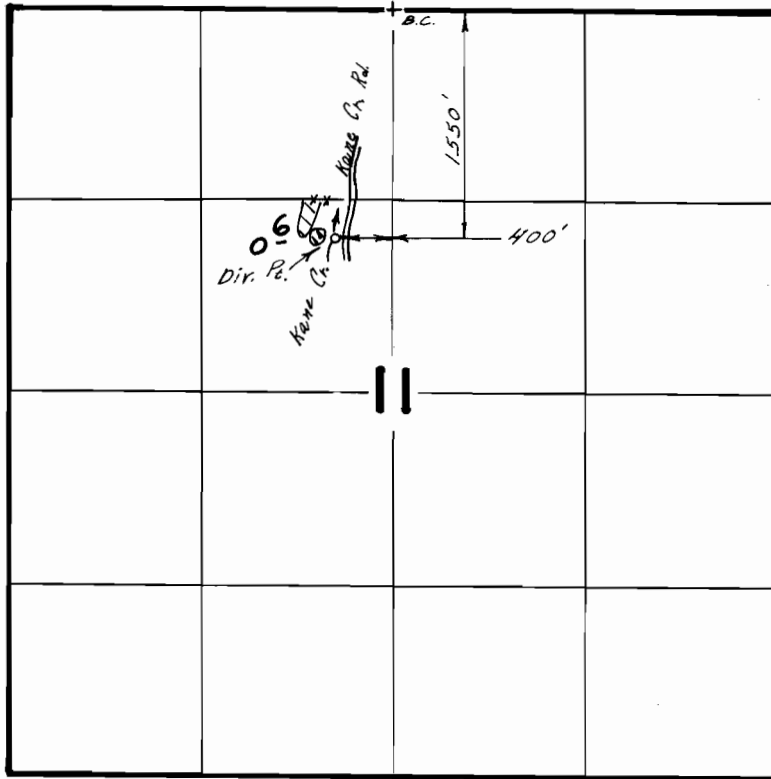

Scale 1" = 1320'



FINAL PROOF SURVEY UNDER

Application No. 53159... Permit No. 38786.....
IN NAME OF

ROBERT F. &/or LENA M. SCHUETTE

Surveyed July 21, 1987, by B.S. JAMES.....