


T. 20S., R. 46E., W.M.

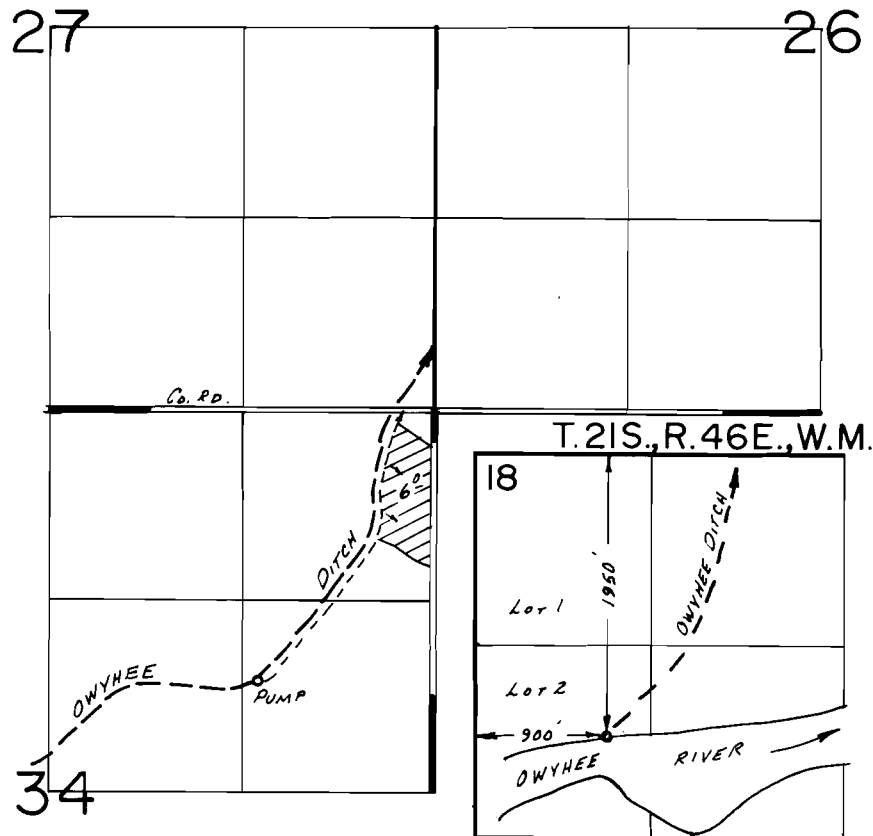

SCALE: 1" = 1320'

# **FINAL PROOF SURVEY** UNDER

Application No. 53430.. Permit No. 40448.....  
IN NAME OF

OWYHEE DITCH COMPANY.....

Surveyed Mar. 31.... 1986, by L.M. TOLL.....