


T.6S.,R.2E.,W.M.

SECTION 26, SCALE 1" = 400'

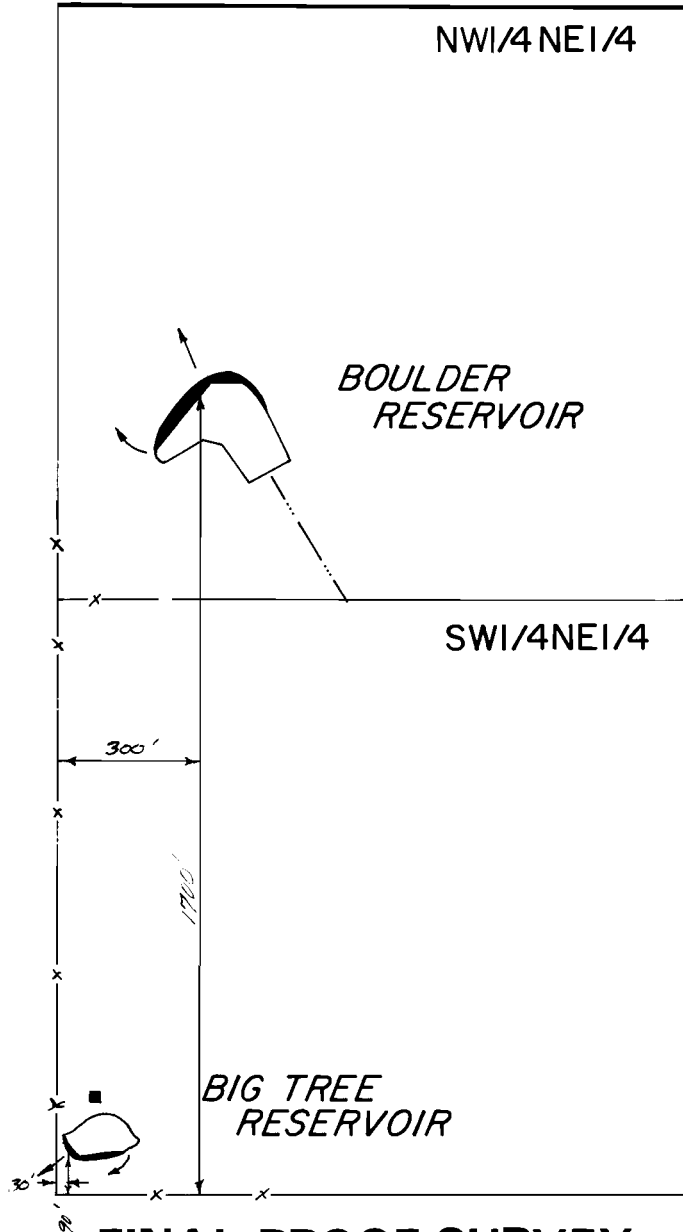

FINAL PROOF SURVEY

UNDER

R-53433 R-6370
Application No. 53434 Permit No. 39618
IN NAME OF

DEARDORFF

Surveyed AUG. 6, 1981, by *allman*