T.2S., R.2W., W.M.

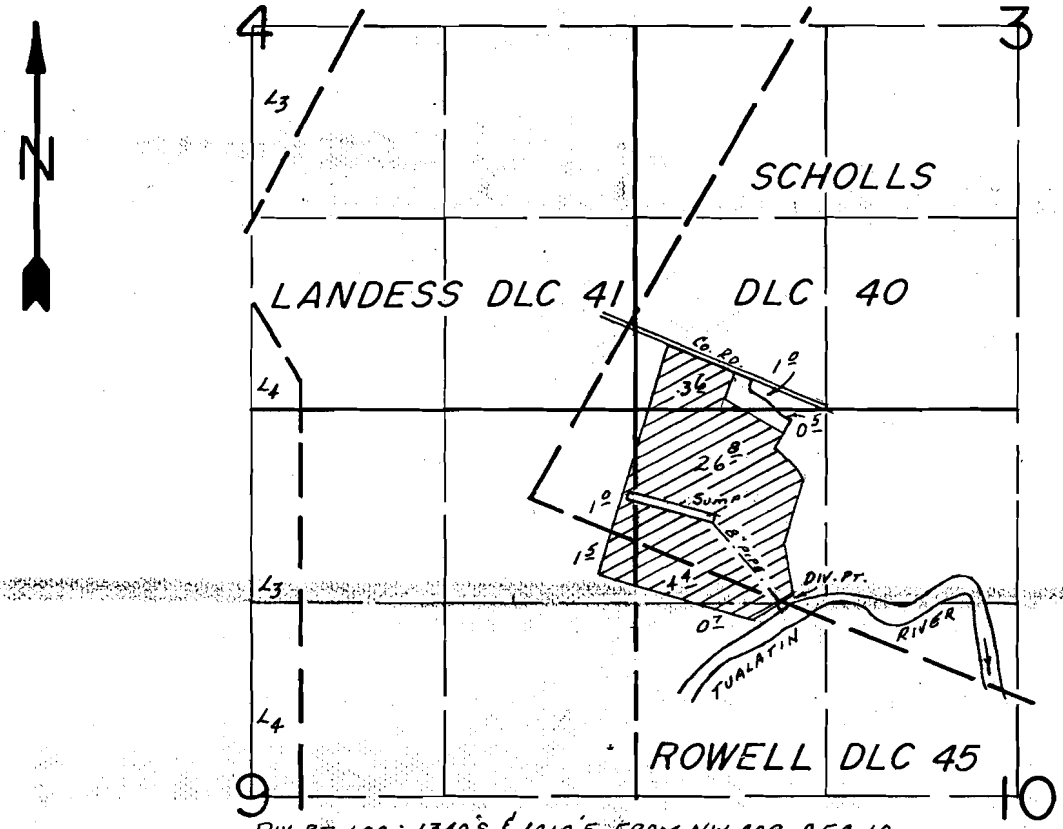

DIV. PT. LOC.: 1340'S. & 1010'E. FROM NW COR. SEC. 10
Res: 650'S & 300'E from NW Cor. Sec. 10

SCALE: 1" = 1320'

FINAL PROOF SURVEY

UNDER

R-53658 R-6275

Application No. 53659 Permit No. 39187

IN NAME OF

ROSI GOLDSMITH

Surveyed Mar. 31 19 86, by T. M. WARREN

4/8/86
GAB

41067-178-162R

REVISED 3/93 JK