


T. 32S., R. 5W., W.M.

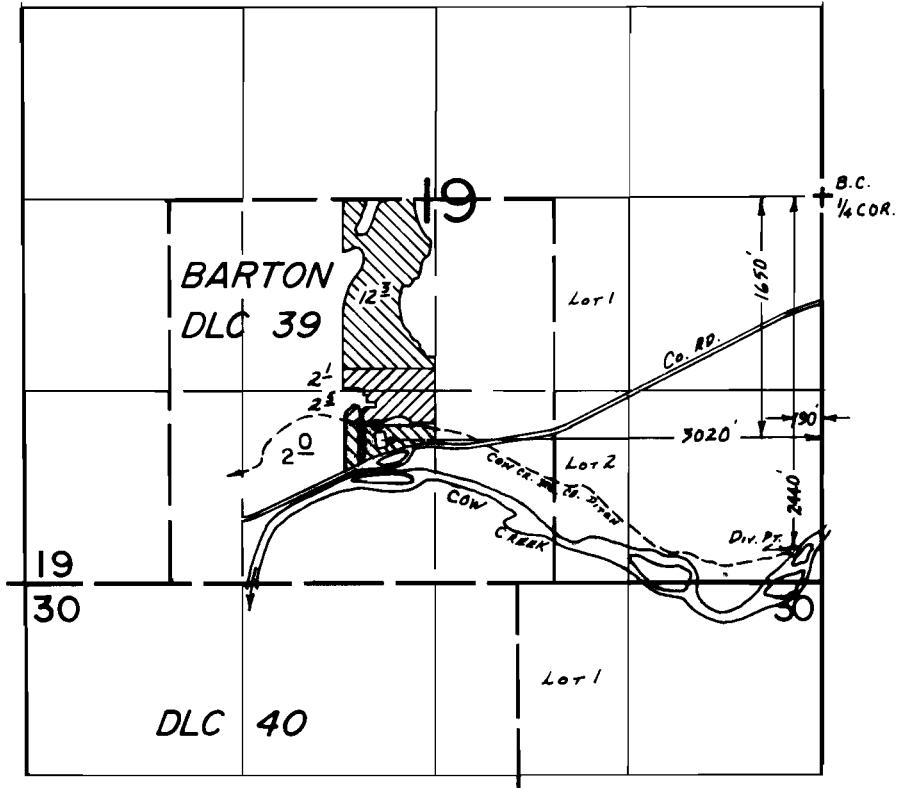

 Tr. 4268

 Per. 40371

SCALE : 4" = 1 MILE

FINAL PROOF SURVEY

UNDER

Transfer No. 4268.

R-53760

R-6435

Application No. 53761 Permit No. 40371.....

IN NAME OF

..... WILLIAM A. VAUGHN

Surveyed JUN. 4 87 J. M. SCHMORDE
 Oct. 15..... 1979., by J. S. DONALDSON

Doug. Co. 76-68-12
 ZTS

REVISED: JAN. 4, 1988 JK

BWB