


T.18S. R.3W. W.M.

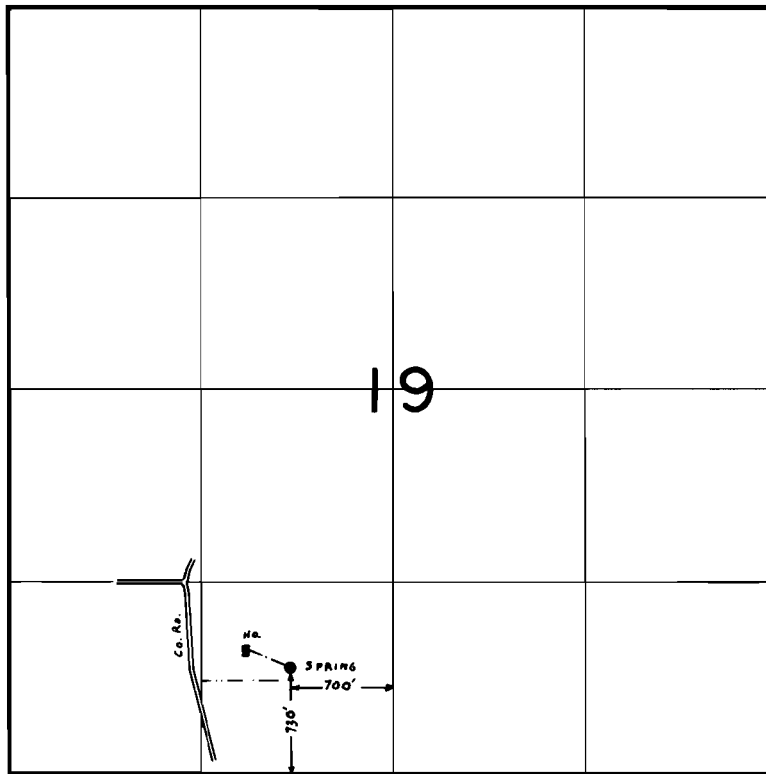

FINAL PROOF SURVEY
UNDER

Application No. 53851 Permit No. 40109
IN NAME OF

STEVEN JOSEPH MAYER

Surveyed June 14 1978, by C. L. HUGHES
May 25 1979