


T. 36 S., R. 4 W., W. M.

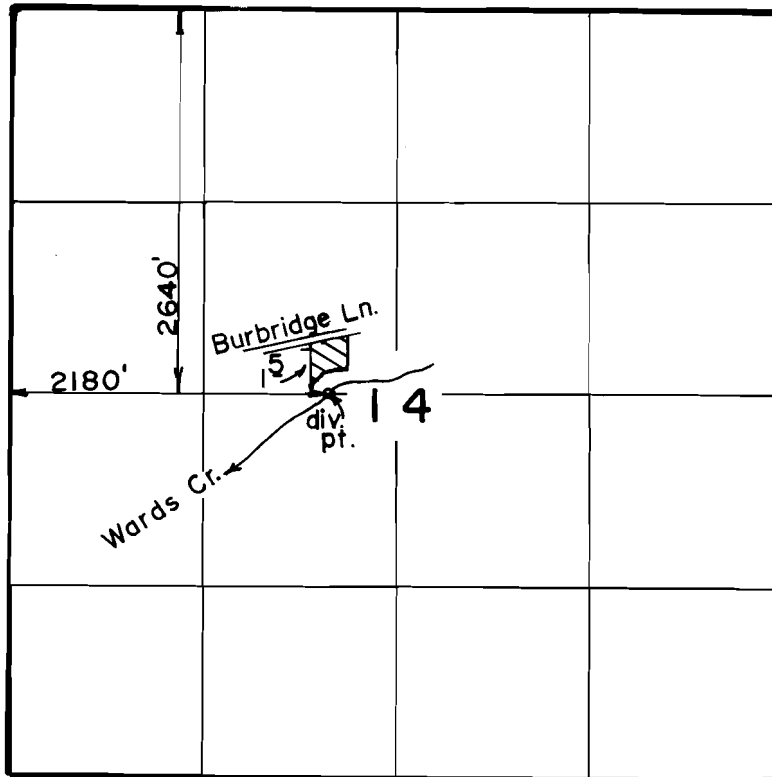

Scale: 1" = 1320'

**FINAL PROOF SURVEY**  
UNDER

Application No. ~~54274~~ Permit No. ~~40644~~  
IN NAME OF

.....NEIL.....BARLOW.....

Surveyed JUL...21.. 1987, by B....S....JAMES.