


T.41S. R.13W. W.M

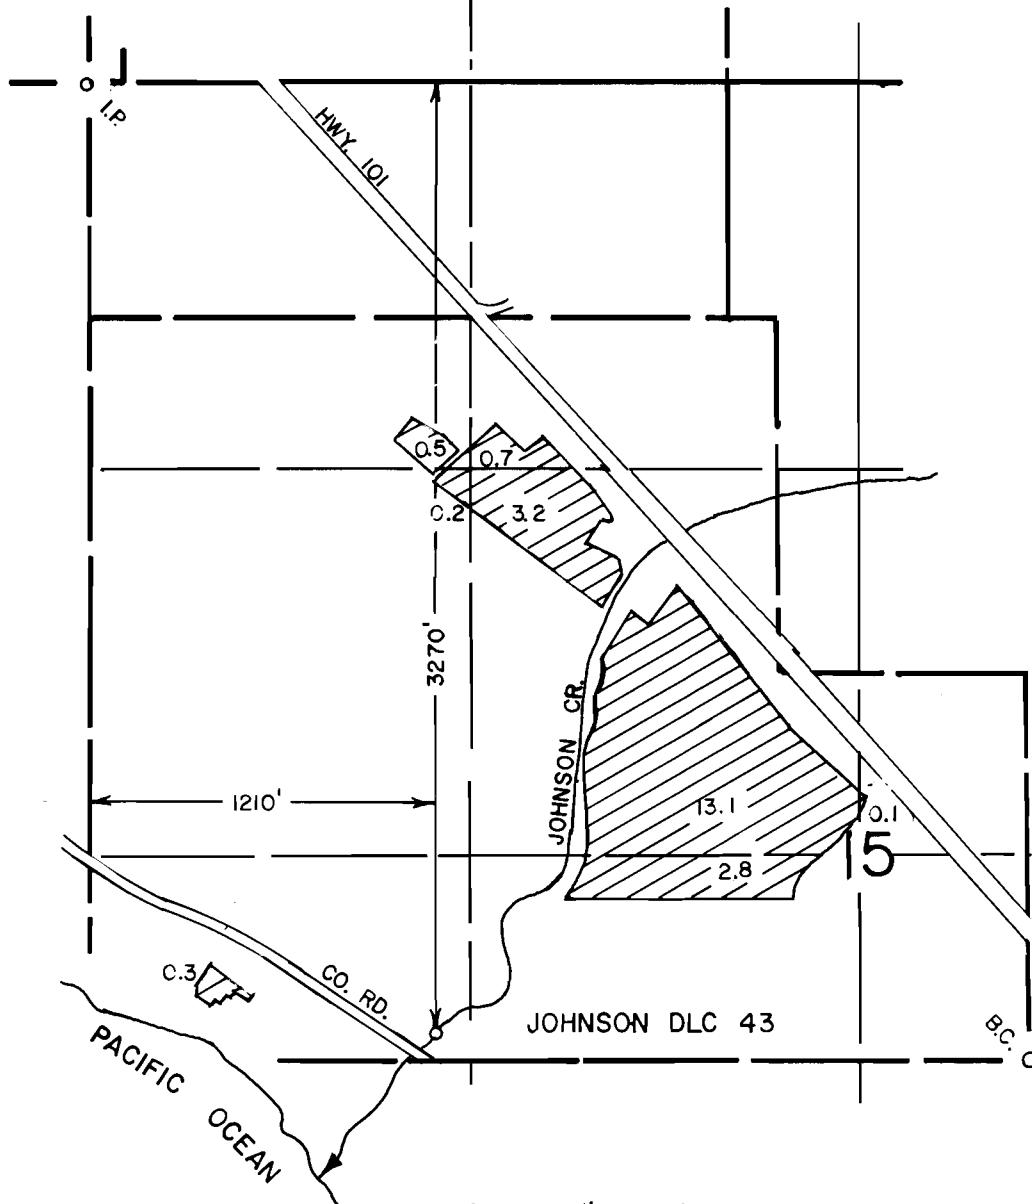

SCALE: 8" = 1 Mile

FINAL PROOF SURVEY UNDER

Application No. 54341... Permit No. 40737.....
IN NAME OF

PETE COWAN.....

Surveyed APR. 10.... 1985., by L. CASHION.....