


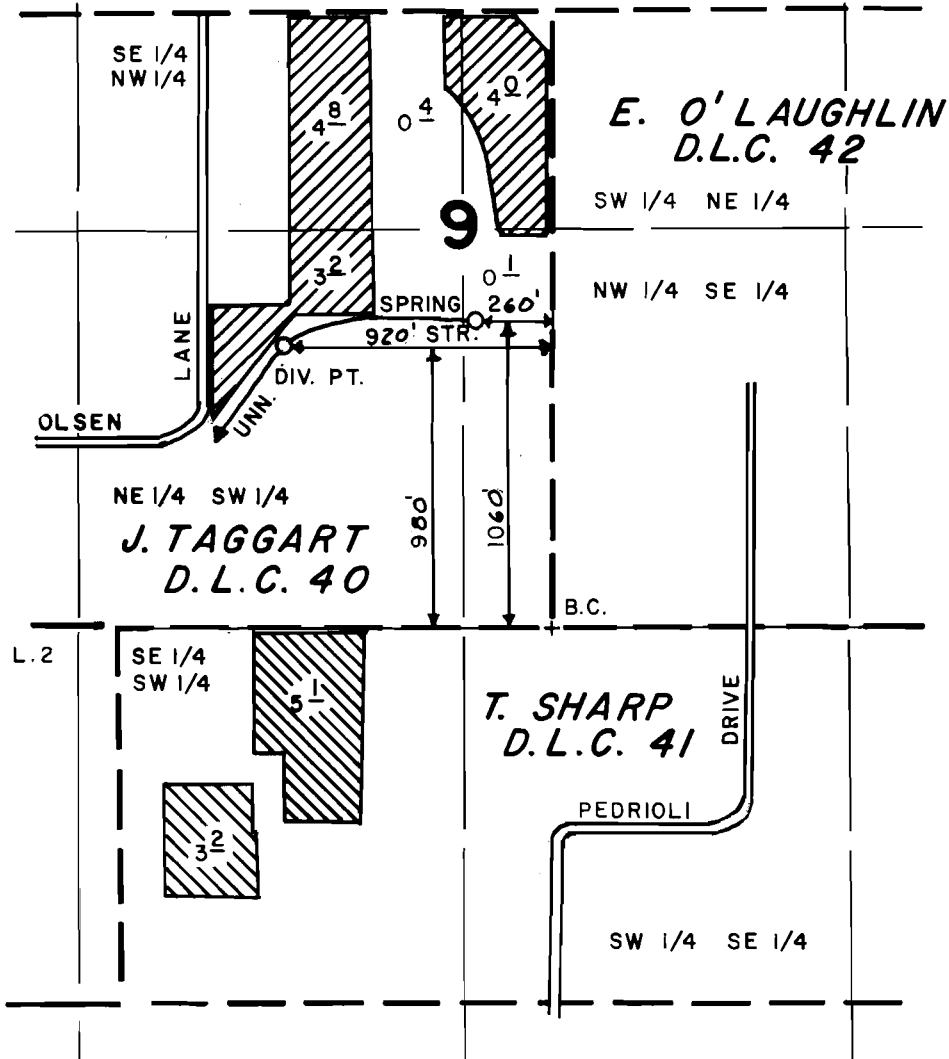

T.41S., R.13W., W.M.



SCALE: 8" = 1 MILE

-  SUPPLEMENTAL IRRIGATION
-  PRIMARY IRRIGATION

FINAL PROOF SURVEY UNDER

Application No. 54342. Permit No. 40797
IN NAME OF

PETE COWAN

Surveyed APRIL 10 1985, by L. E. CASHION.