


T1S, R4W, WM

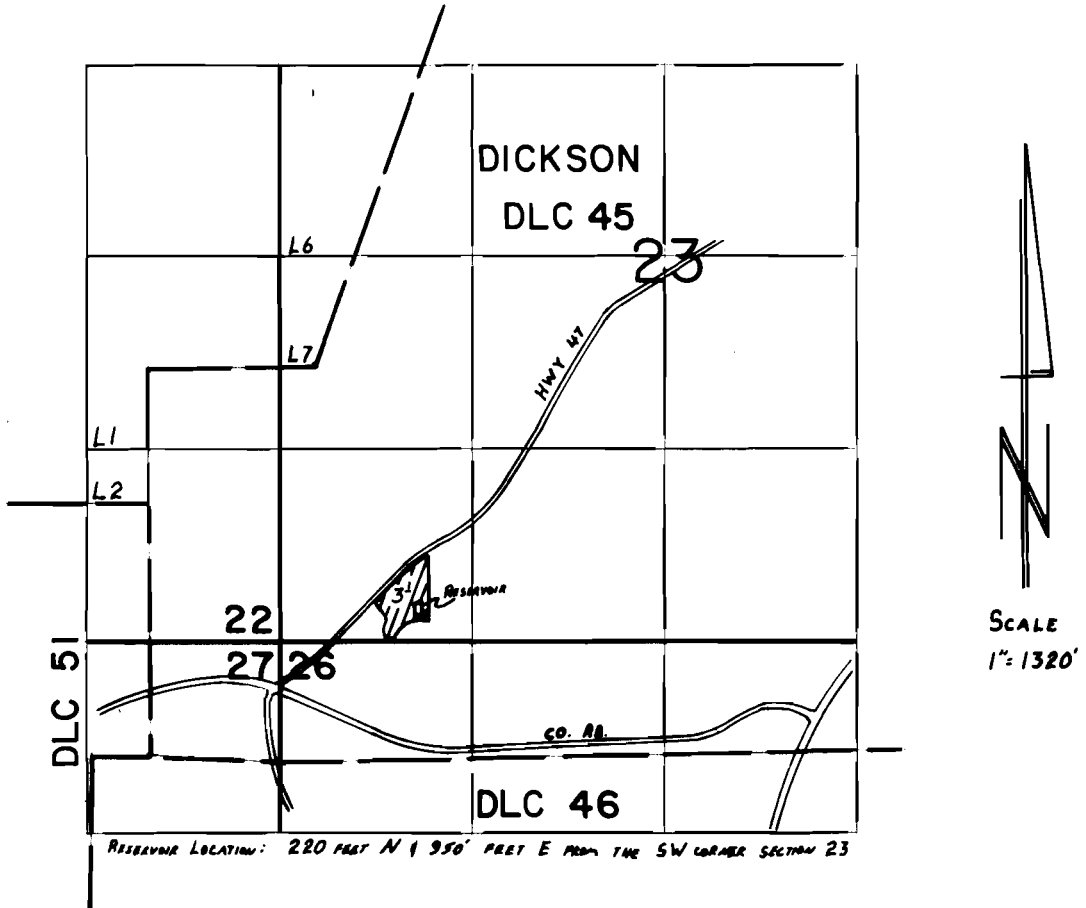

FINAL PROOF SURVEY UNDER

R-54353 R-6493
Application No. 54354. Permit No. 40689.....
IN NAME OF

DOUGLAS & PHYLLIS JEROME

Surveyed AUG. 9. 1988, by T. M. WARREN.....