


T. 38 S., R. 8 W., W.M.

Sec. 34

NE 1/4 SE 1/4

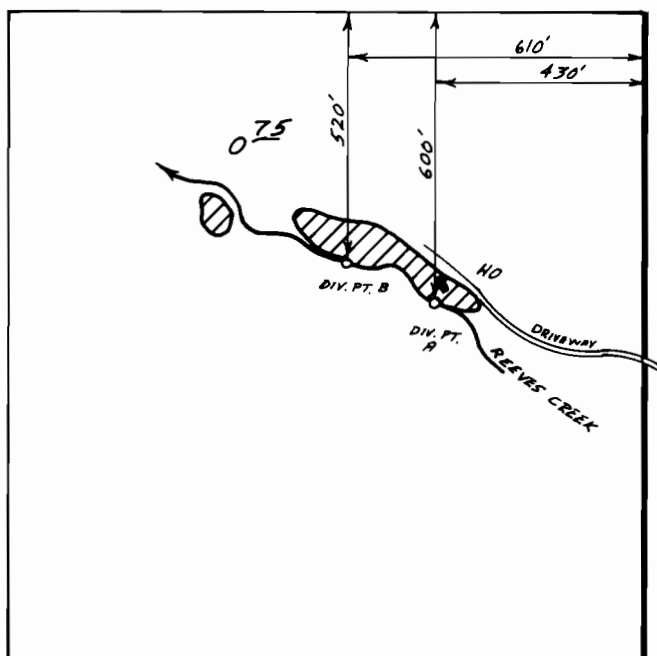

Scale 1"=400'

FINAL PROOF SURVEY
UNDER

Application No. 54571 Permit No. 40950
IN NAME OF

KATHLEEN WILLIAMS

Surveyed JUNE 10, 1986, by B.S. JAMES