


T. 26S., R. 7W., W. M.

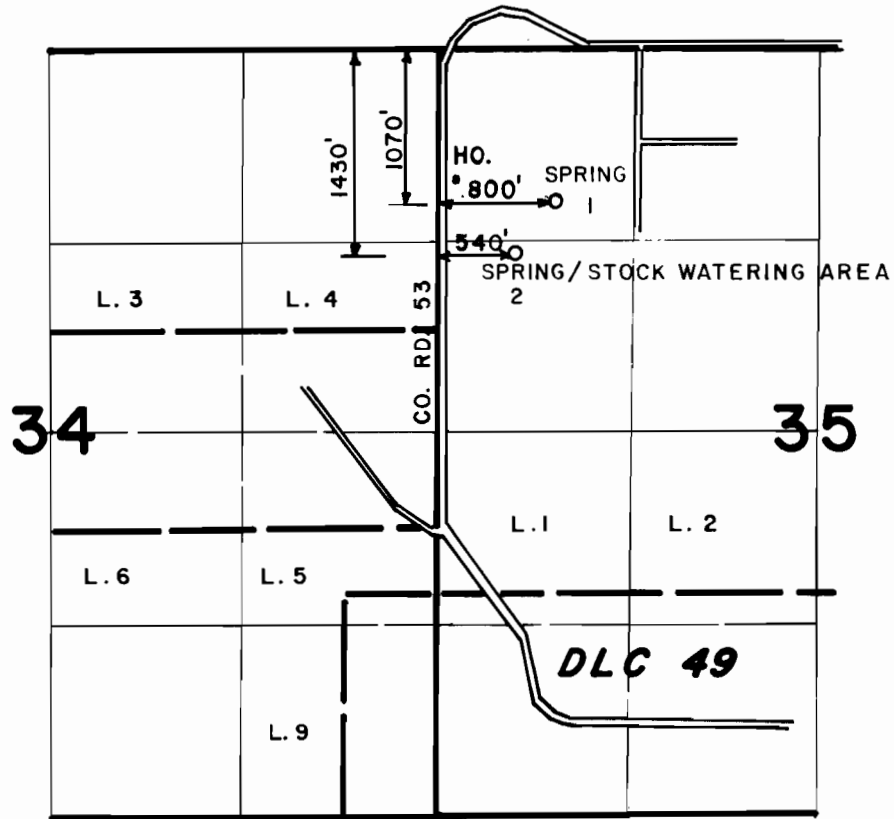

SCALE: 4" = 1 MILE

**FINAL PROOF SURVEY**  
UNDER

Application No. 54582 Permit No. 40957  
IN NAME OF

**J. H. SAND**

Surveyed JUNE 15, 1988, by J. M. SCHMORDE