


T. 29 S., R. 7 W., W.M. SECTION 8

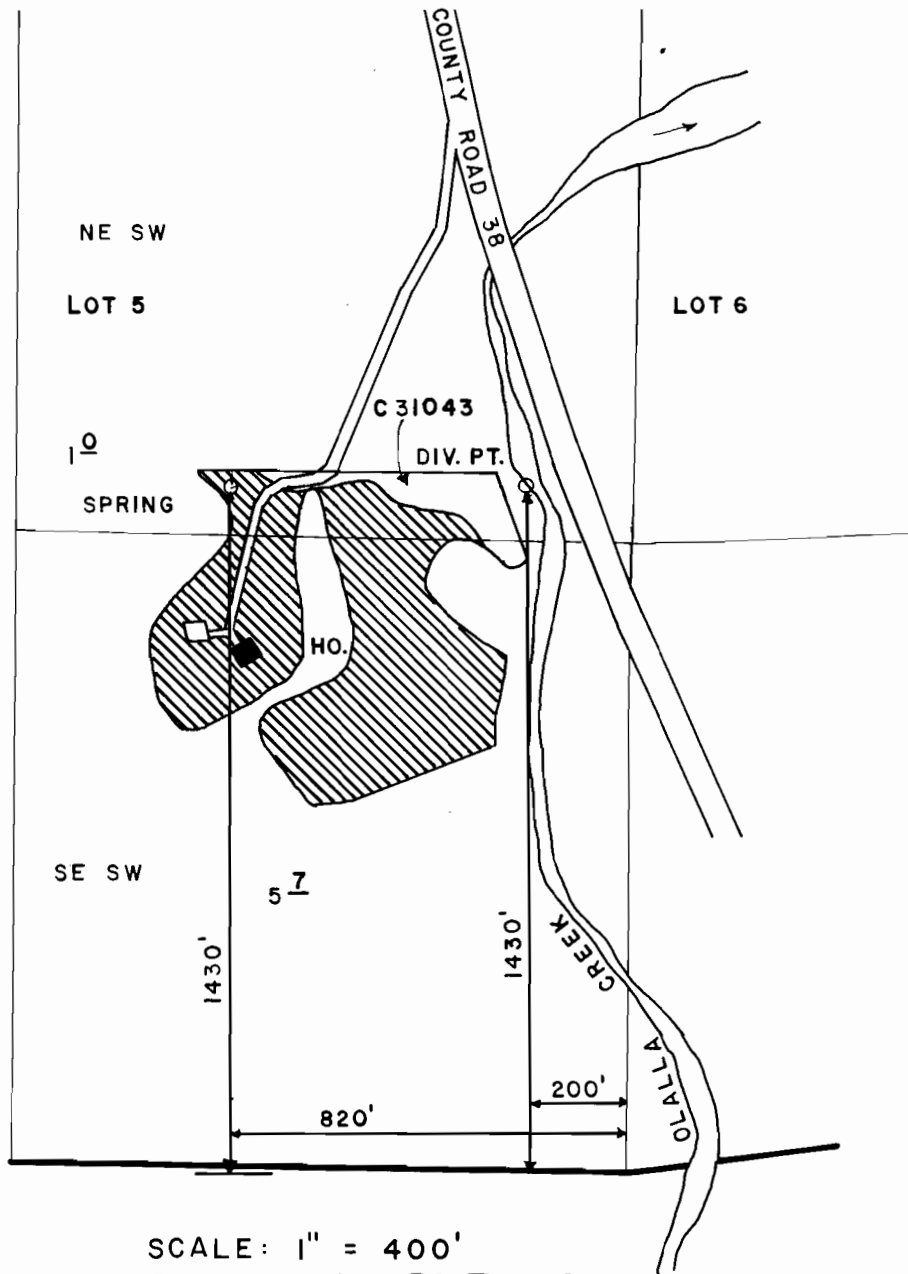

SCALE: 1" = 400'
FINAL PROOF SURVEY
UNDER

Application No. 54774. Permit No. 41098.....
IN NAME OF

KEITH & EVELYN HUSEN

Surveyed JULY 14... 1987., by J.M. SCHMORDE.