


T.1S., R. 2W., W.M.

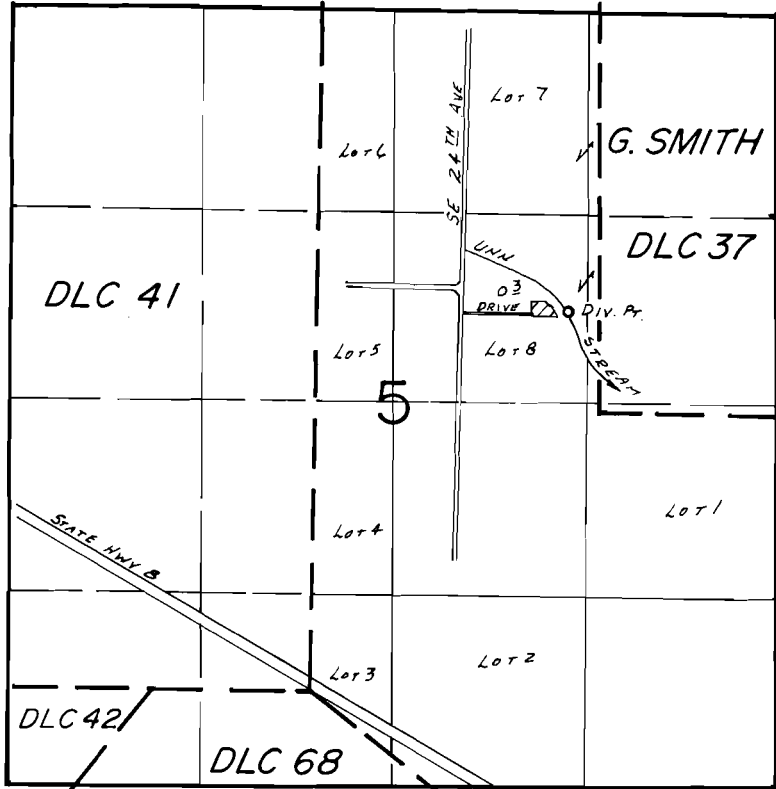

Div. Pt. Loc.: 700' N. & 210' W. FROM SW COR. G. SMITH DLC 37

FINAL PROOF SURVEY
UNDER

Application No. 54878. Permit No. 41574.....
IN NAME OF

.....GREGORY E. MILNES.....

Surveyed Aug. 27. 19.86, by B.W. BISHOP.....

1-27-87
BWB

41067-178-160D