


RECEIVED

JAN 7 1977

**SOURCES DEPT.
OREGON**

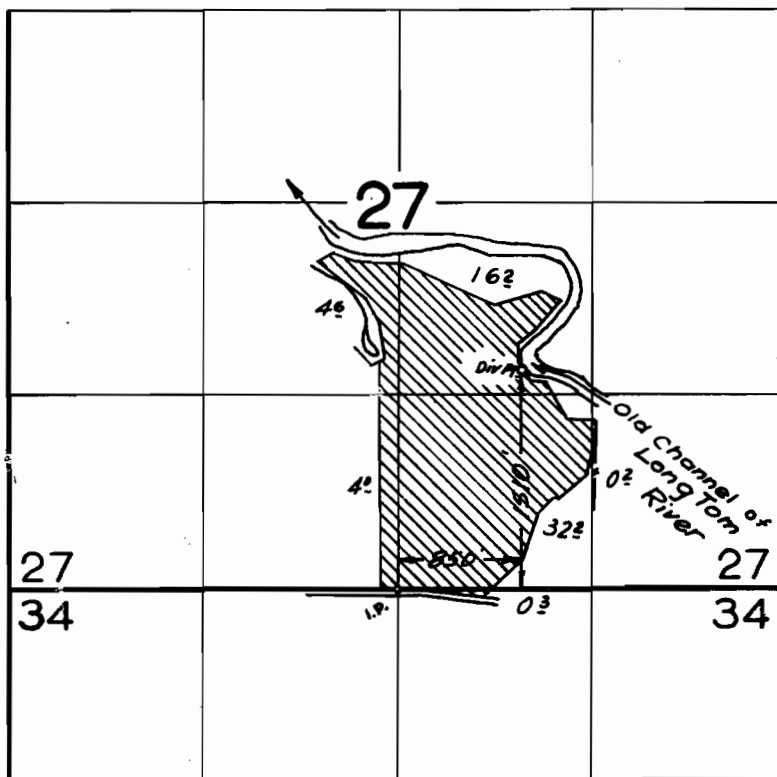

Application No. 55084
Permit No. 41580

Application No. 31584 Permit No. 24917
IN NAME OF

JUPE HOLM

Surveyed April 3 1959, by R. H. Jackson