


T. 15S. R. 5W. W.M.

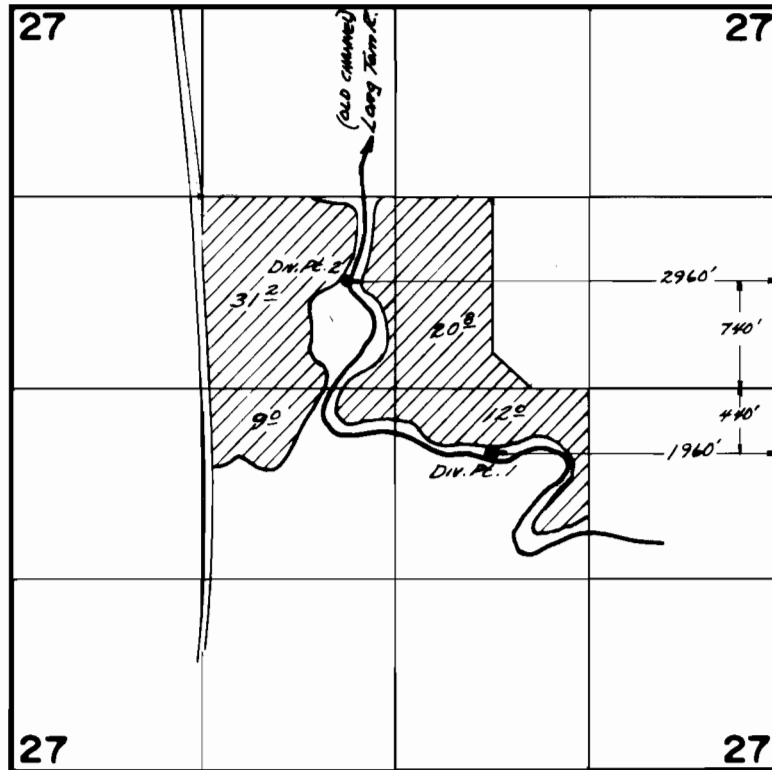

FINAL PROOF SURVEY
UNDER

Application No. 55085. Permit No. 41581.....
IN NAME OF

.....**JUPE HOLM**.....

Surveyed Oct...11.... 1979., by C.R. RODRIGUEZ.