


# T. 4S., R. 1E., W.M.

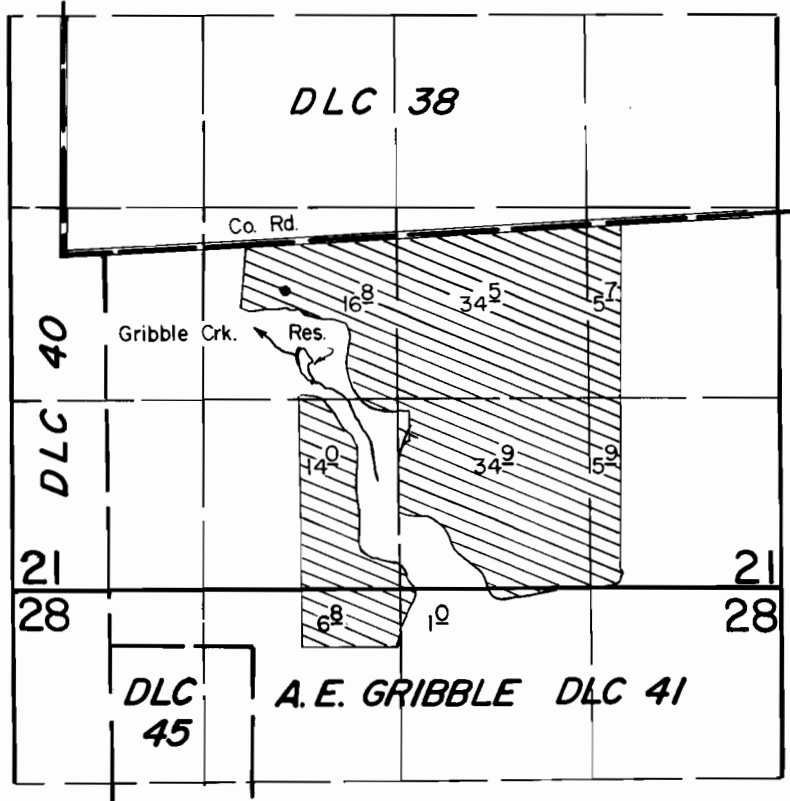

Dam P.O.D. Loc. : 700' S. & 1300' E. from NW Cor. DLC 41.

Scale : 1" = 1320'

## FINAL PROOF SURVEY

UNDER

R-55414                      R-6617  
 Application No. 55415    Permit No. 41812.....  
 IN NAME OF

**FRANK LAIS**

Surveyed JULY 2... 1986, by T. Warren.....