
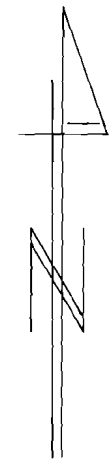


TIIS, RIOW, WM

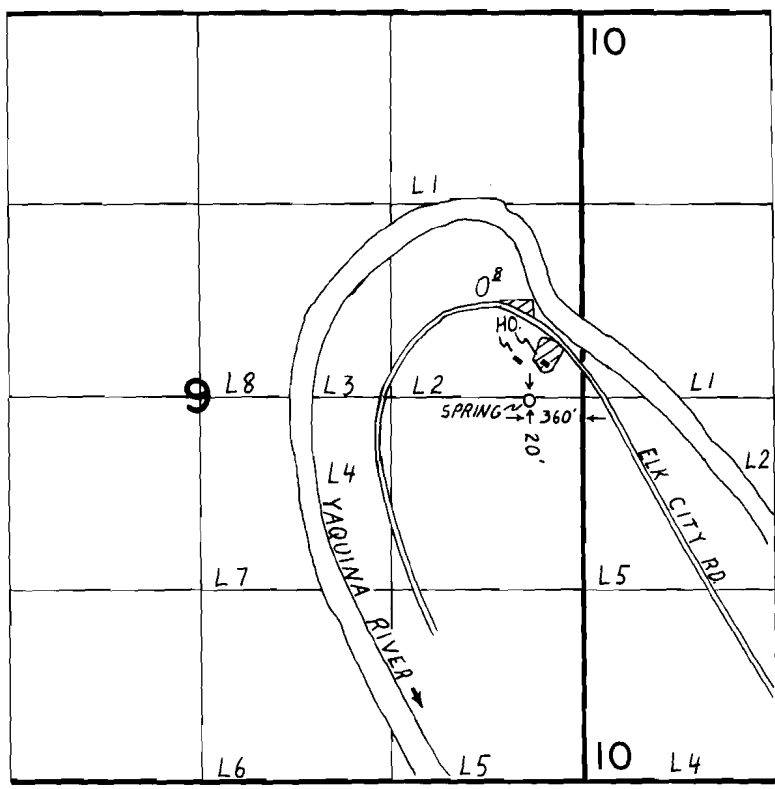

1" = 1320'

FINAL PROOF SURVEY UNDER

Application No. 55496 Permit No. 42395....
IN NAME OF

LON...C... & DENISE...C...BENTSEN

Surveyed MAY...23. 1988., by T.M...WARREN...