




T.24S.,R.13 W.,W.M.

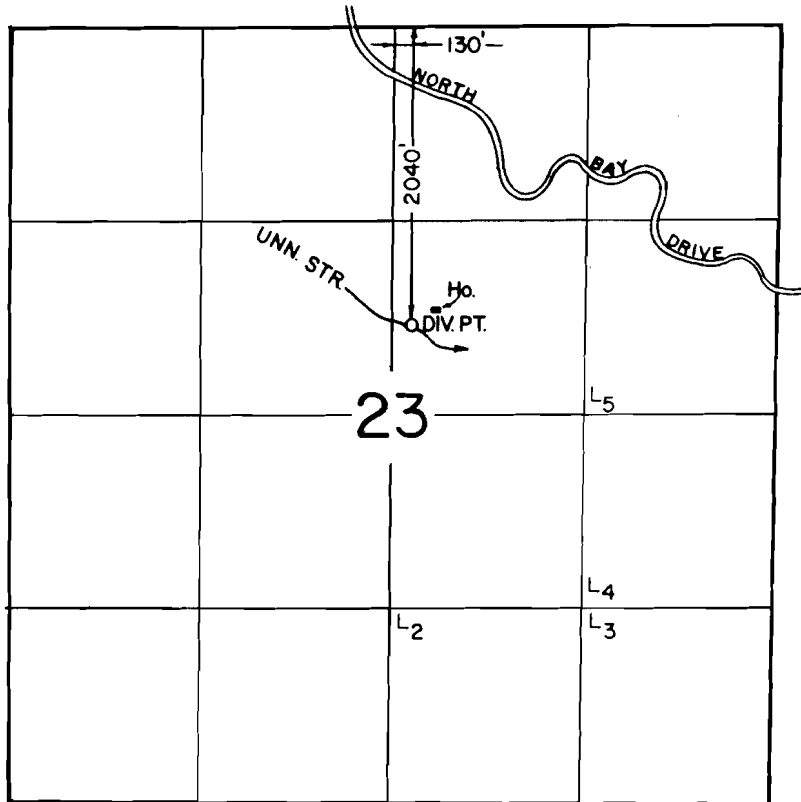

SCALE: 1" = 1320'

FINAL PROOF SURVEY
UNDER

Application No. 56154... Permit No. 42174.....
IN NAME OF

MARY S. & THOMAS M. HOSHALL

Surveyed SEPT. 18, 1988, by V. L. CHURCH.....