




T. 25 S., R. 12 W., W.M.

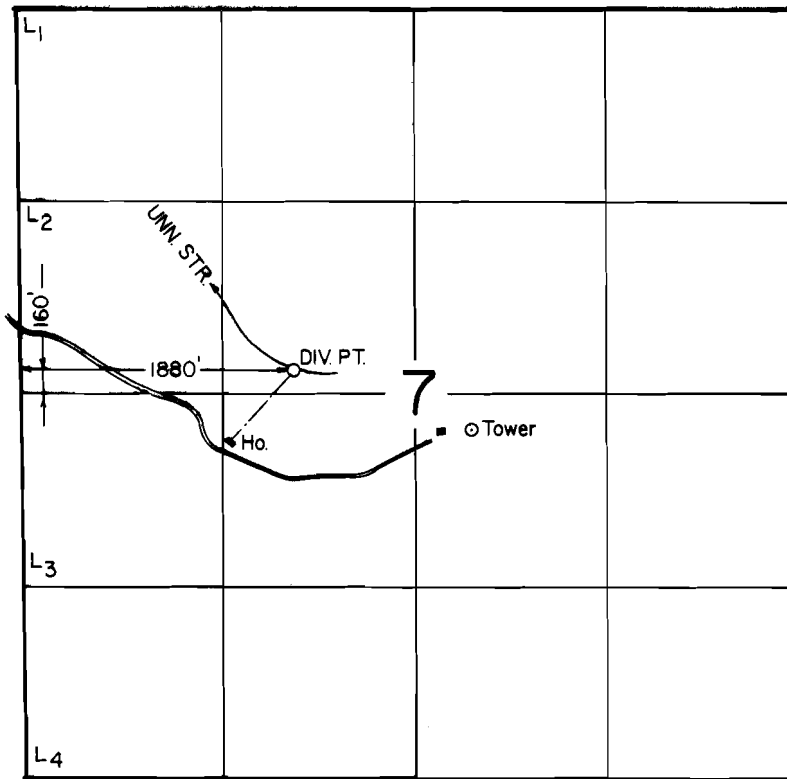

SCALE: 1" = 1320'

**FINAL PROOF SURVEY**  
UNDER

Application No. 56783.. Permit No. 42575.....  
IN NAME OF

RICHARD J. PATTERSON.....

Surveyed NOV. 16... 1978., by S. DONALDSON..