


T. 14 S., R. 7 & 8 W., W.M.

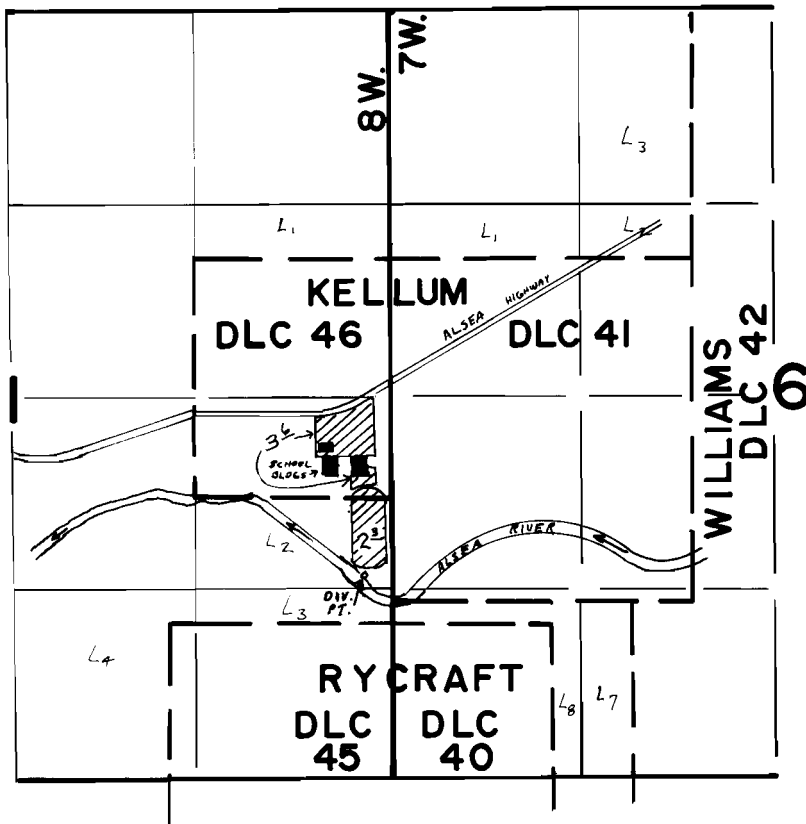

DIV. PT. LOC. : 1400' N. & 160' W. from the SE Cor.
Section 1

FINAL PROOF SURVEY
UNDER

Application No. 57009.. Permit No. 42912.....
IN NAME OF

BENTON COUNTY SCHOOL DISTRICT 7J

Surveyed JUNE 15.. 1983., by L. TOLL.....