




T. 23 S., R. 13 W., W.M.

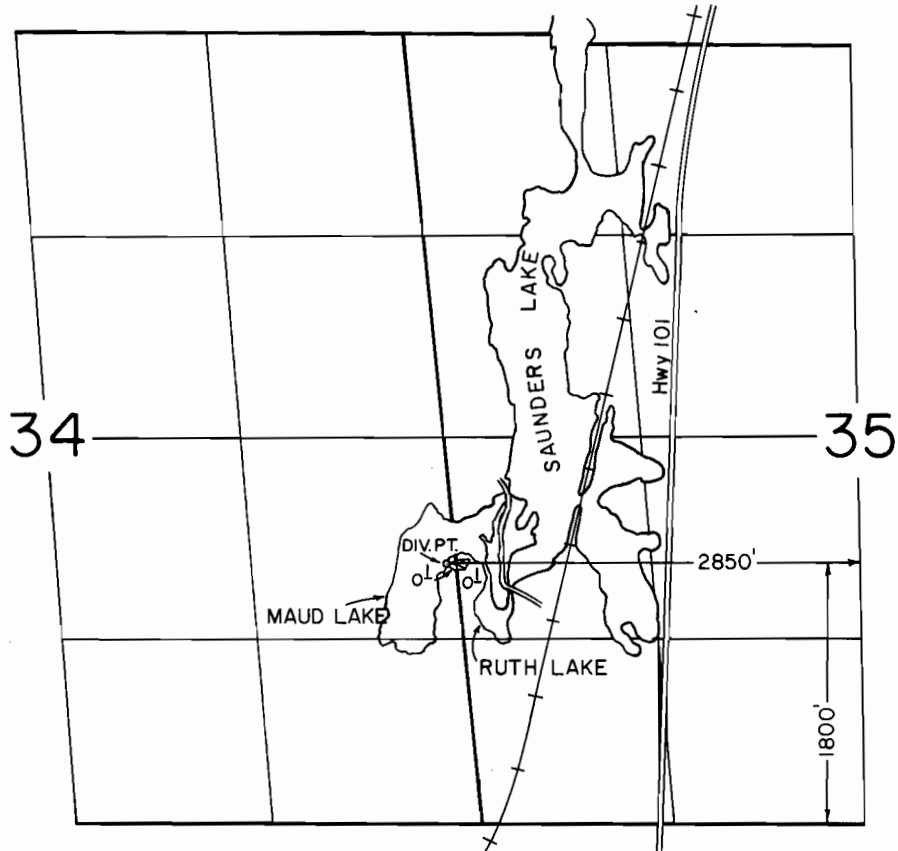

SCALE: 1" = 1320'

**FINAL PROOF SURVEY**  
UNDER

Application No. 57277... Permit No. 43125.....  
IN NAME OF

GARNET JOHNSON

Surveyed SEPT. 17, 1988, by V. L. CHURCH