




T. 23 S., R. 12 W., W.M.

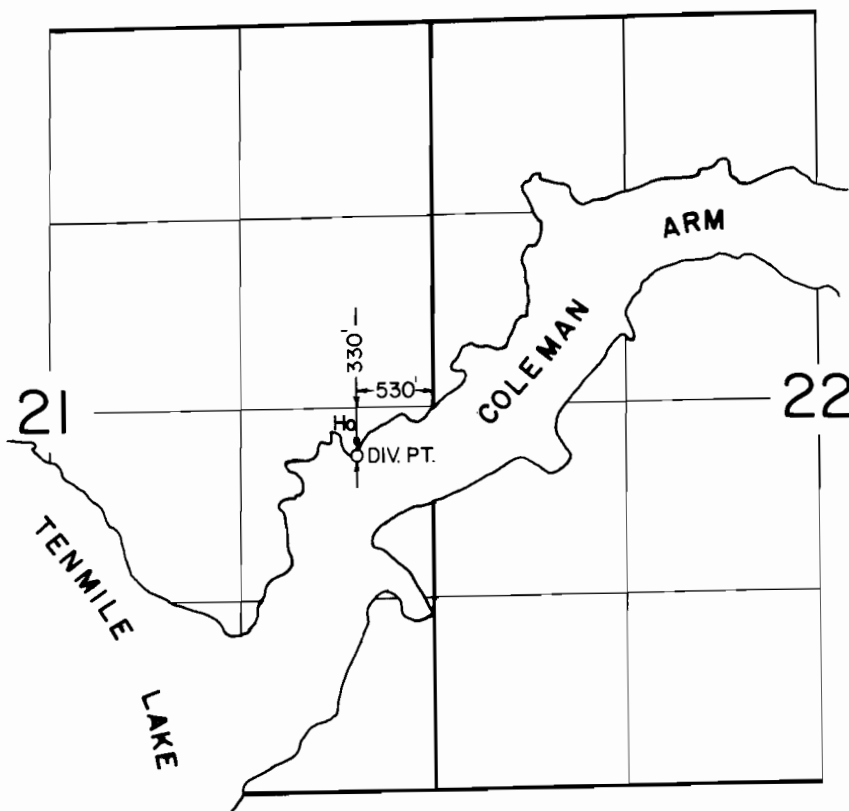

SCALE: 1" = 1320'

FINAL PROOF SURVEY
UNDER

Application No. 57767. Permit No. 43502....
IN NAME OF

KENNETH R. & BETTY A. FREUDENBERG

Surveyed SEPT. 21, 1988, by V. L. CHURCH....