




T.24S.,R.12W.,WM.

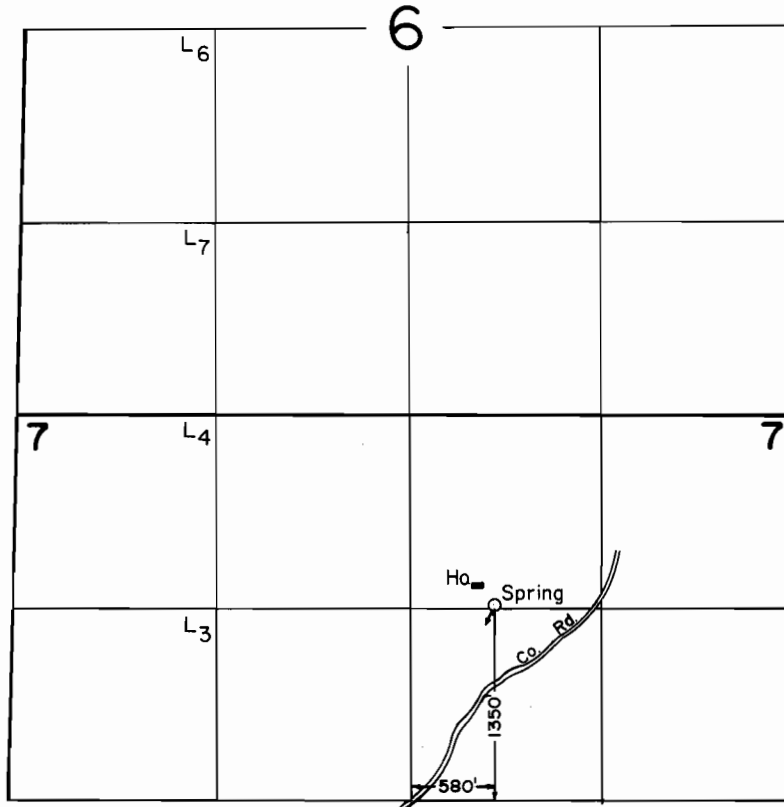

SCALE: 1" = 1320'

FINAL PROOF SURVEY
UNDER

Application No. 57935.. Permit No. 43695.....
IN NAME OF

SERGIO A. & MARGARET J. VASQUEZ

Surveyed SEPT. 19. 1988, by J.C. LARSON.....