




T. 23 S., R. 13 W., W.M.

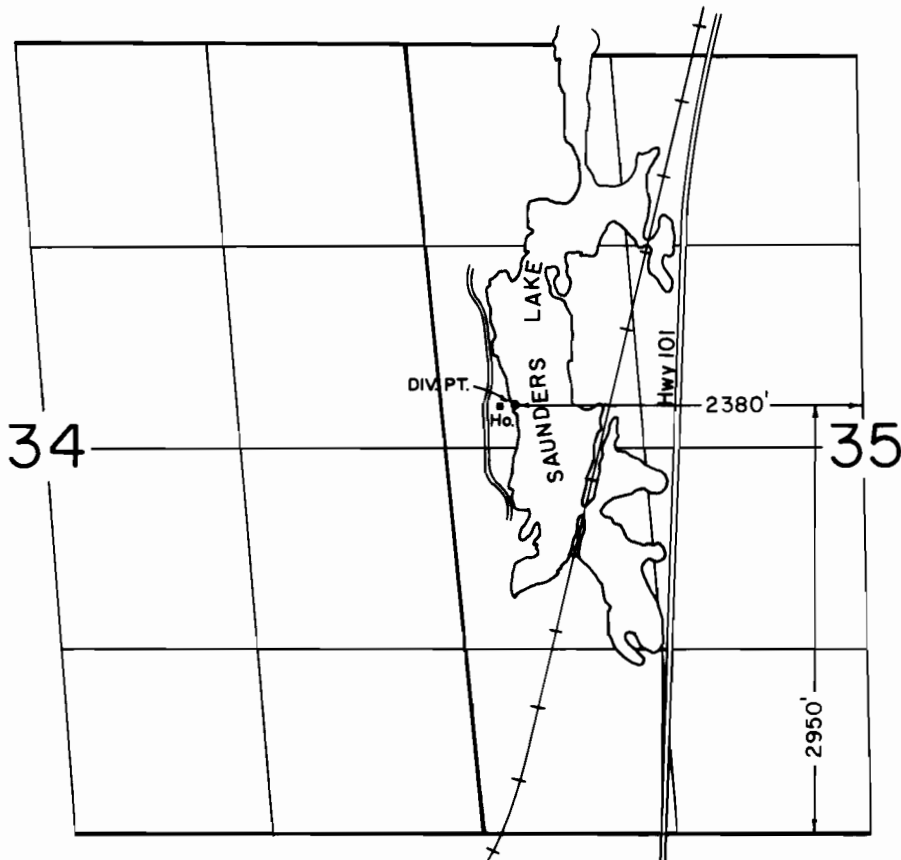

SCALE: 1" = 1320'

FINAL PROOF SURVEY
UNDER

Application No. 58064... Permit No. 43801.....
IN NAME OF

AMELIA H. LIPTON & EDWIN J. QUINN

Surveyed SEPT. 17, 1988, by V. L. CHURCH.....