


T. 23 S., R. 12 W., W.M.

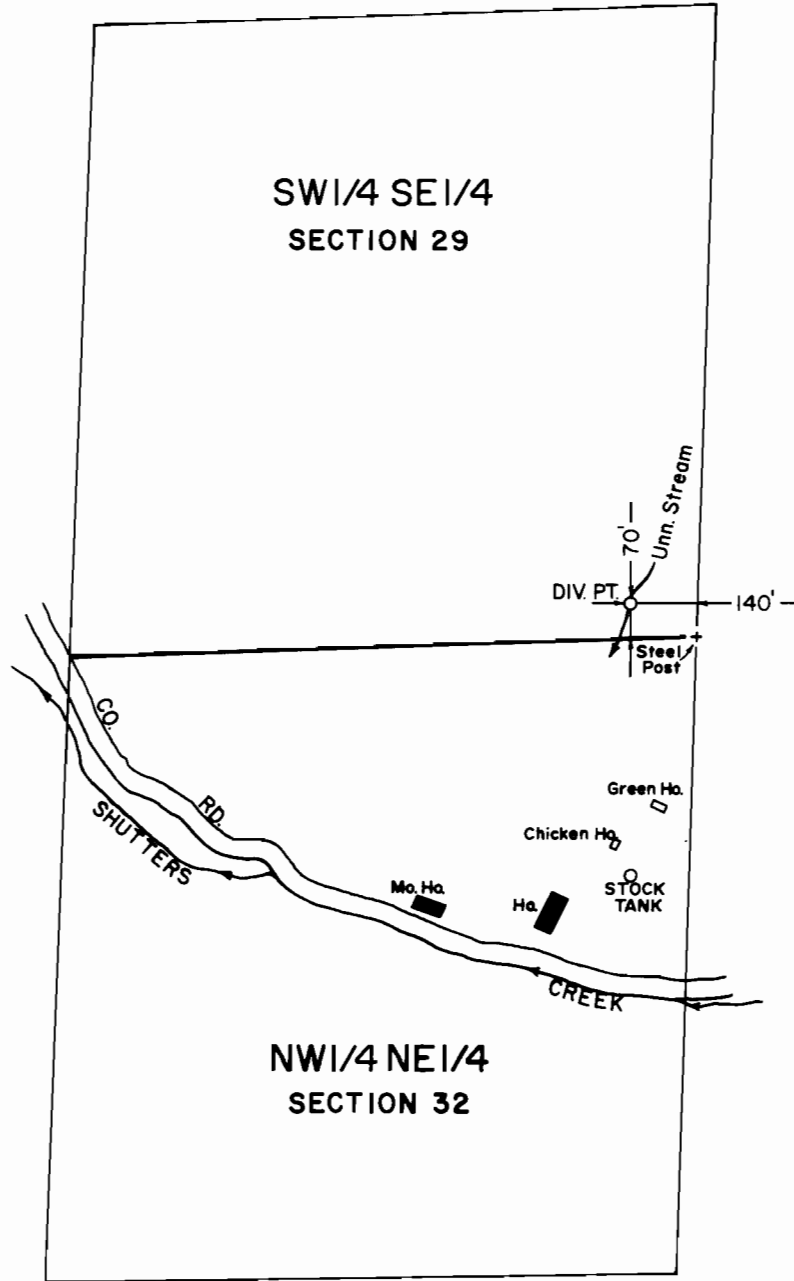

SCALE: 1" = 400'

**FINAL PROOF SURVEY**  
UNDER

Application No. 58198... Permit No. 43950...  
IN NAME OF

..... FRANCIS J. WHITTEN .....

Surveyed SEPT. 17, 1988, by T. M. WARREN...