


T. 3 S., R. 4 W. WM

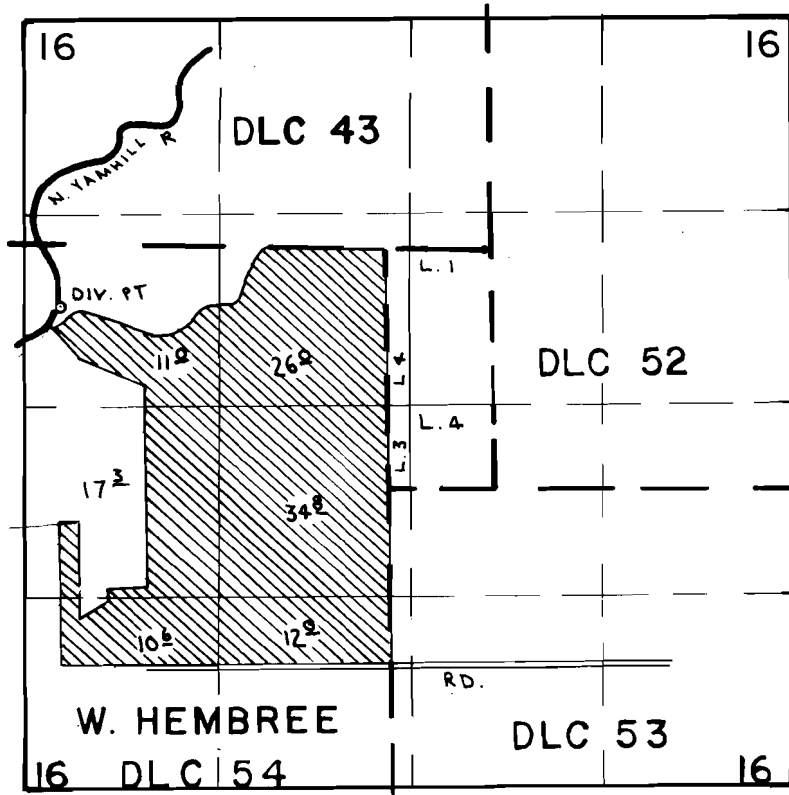

DIV. PT. LOC.: 380' S. & 2240' W. OF NE COR. DLC 54

FINAL PROOF SURVEY UNDER

Application No. 58735 Permit No. 44209
IN NAME OF

FIDEL BROS.

Surveyed JUL 10 1984, by P. PAGTER