


T. 13 S., R. 1 W., W. M.

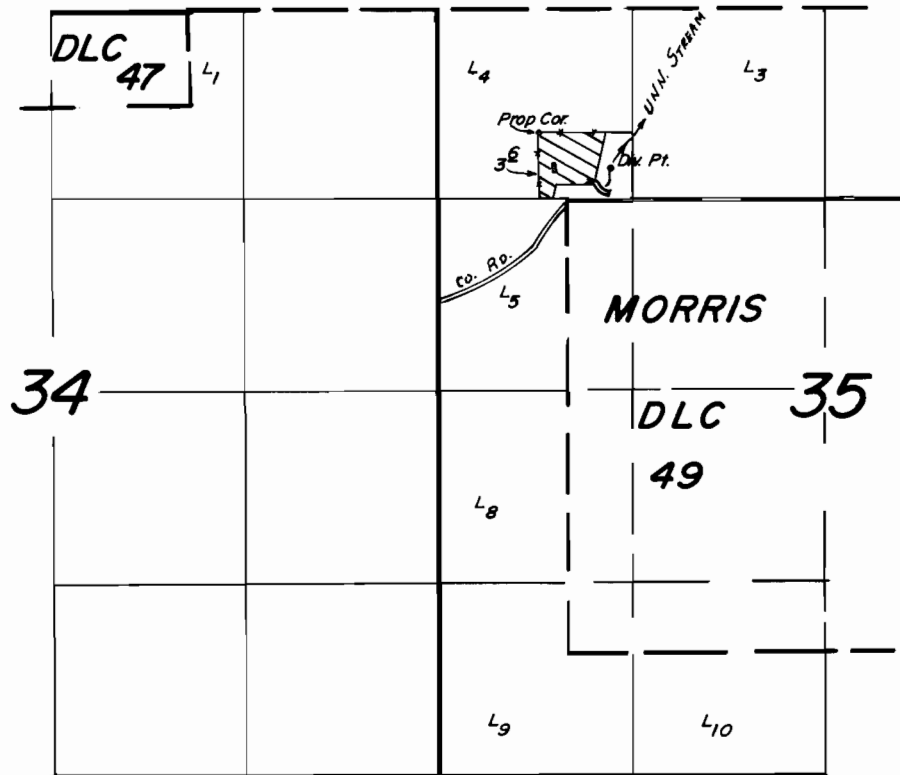

Div. Pt. Loc.: 1090' S. & 1180' E. from NW Cor. Sec. 35.

Scale: 1" = 1320'

FINAL PROOF SURVEY UNDER

Application No. 59239 Permit No. 44468
IN NAME OF

RONALD A. & MARIA E. HARTMANN

Surveyed JUNE 14, 1984, by L. TOLL