


T. 26 S., R. 6 W., W.M.

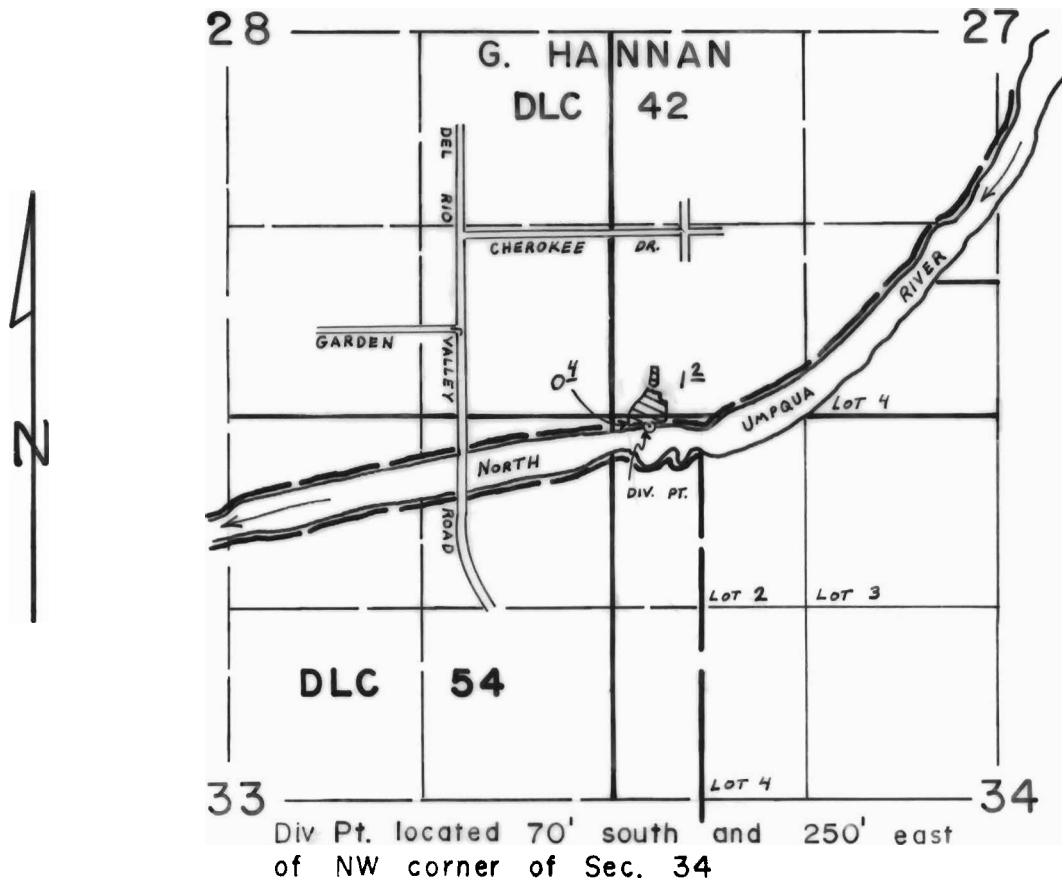

SCALE: 4" = 1 mile

FINAL PROOF SURVEY
UNDER

Application No. 594.05. Permit No. 44700.....
IN NAME OF

THOMAS & CAROL SCHMID

Surveyed NOV.....14. 19.83., by *L. E. Cashion*...