


T. 1 N., R. 3 W., W. M.

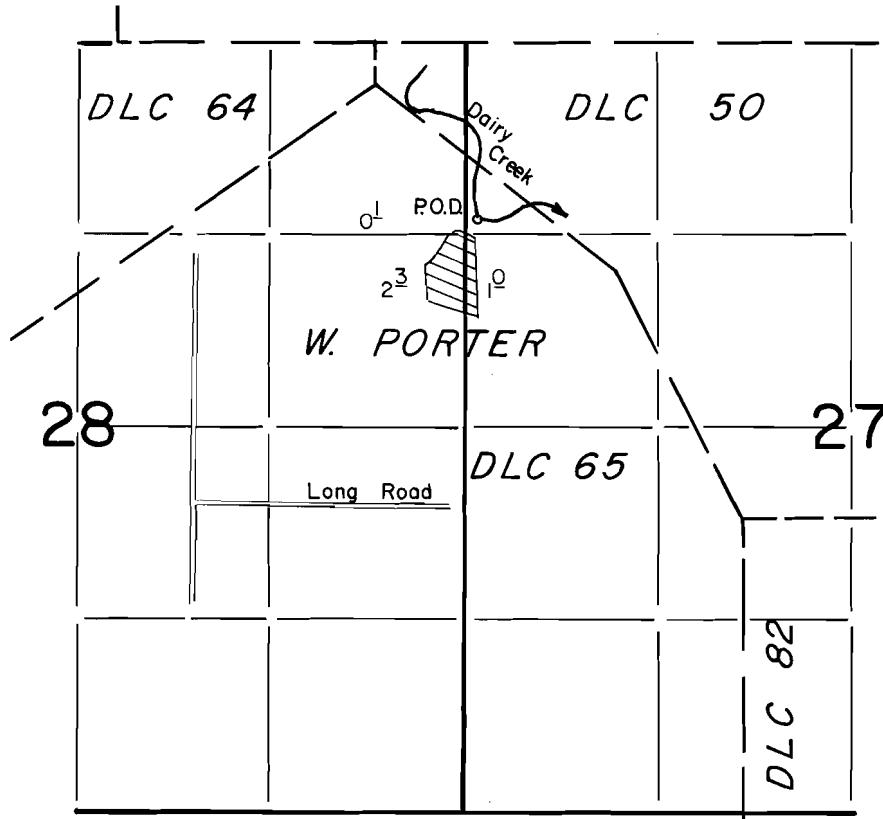

P.O.D. Loc. : 1200' S. & 80' E. from NE Cor. Sec. 28

Scale : 1" = 1320'

FINAL PROOF SURVEY UNDER

Application No. 59823.. Permit No. 45566....
IN NAME OF

RONALD D. KING

Surveyed AUG. 21, 1984, by Ben. Bishop.....
& AUG. 8, 1988, by T. Warren