


T. 40 S., R. 13 W., W. M.

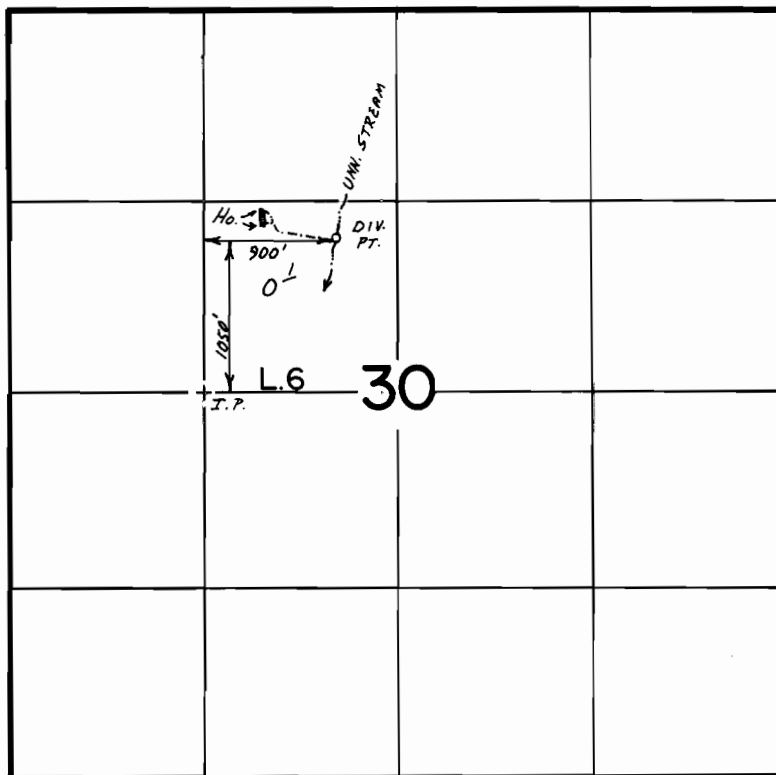

Scale 1" = 1320'

FINAL PROOF SURVEY
UNDER

Application No. 59836.. Permit No. 46004.....
IN NAME OF

.....JUSTIN.....G.....MEZEY.....

Surveyed May..20., 19.87., by J.M. SCHMORDE