
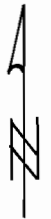


# T.9S., R.45E., W.M.

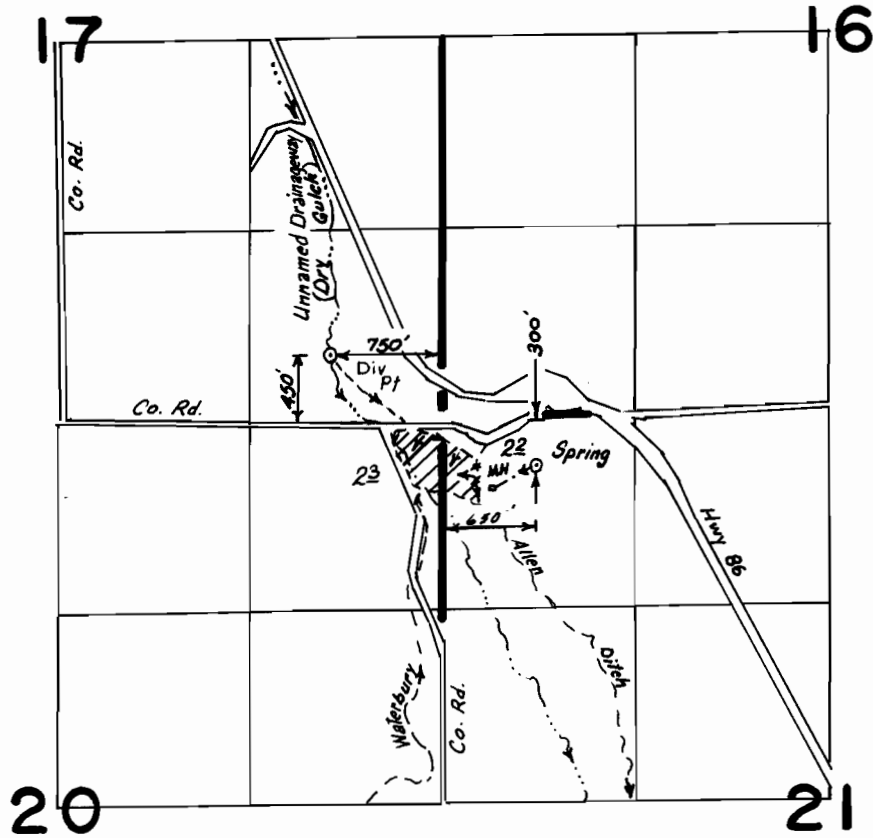

Scale: 1" = 1320'

## FINAL PROOF SURVEY UNDER

Application No. **59882** Permit No. **45473**  
IN NAME OF

**DANIEL C. & DONNA JO LYDON**

Surveyed **10-25** 1988, by **Kenn Kemp**