


T. 27 S., R. 6 W., W.M.

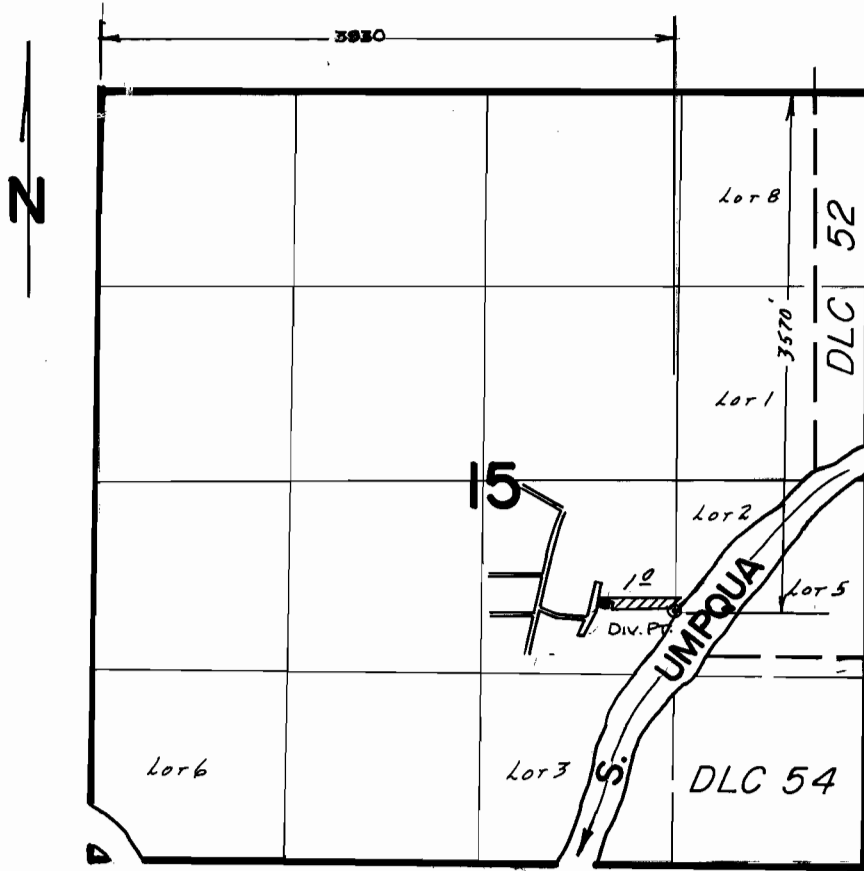

SCALE : 4" = 1 MILE

FINAL PROOF SURVEY
UNDER

Application No. ..59910... Permit No. ...45071.....
IN NAME OF

.....CARL AND LINDA MOTTLE.....

Surveyed .MAY..9,.. 19.84, byL.E..CASHION.