




T.23S.,R.13W.,W.M.

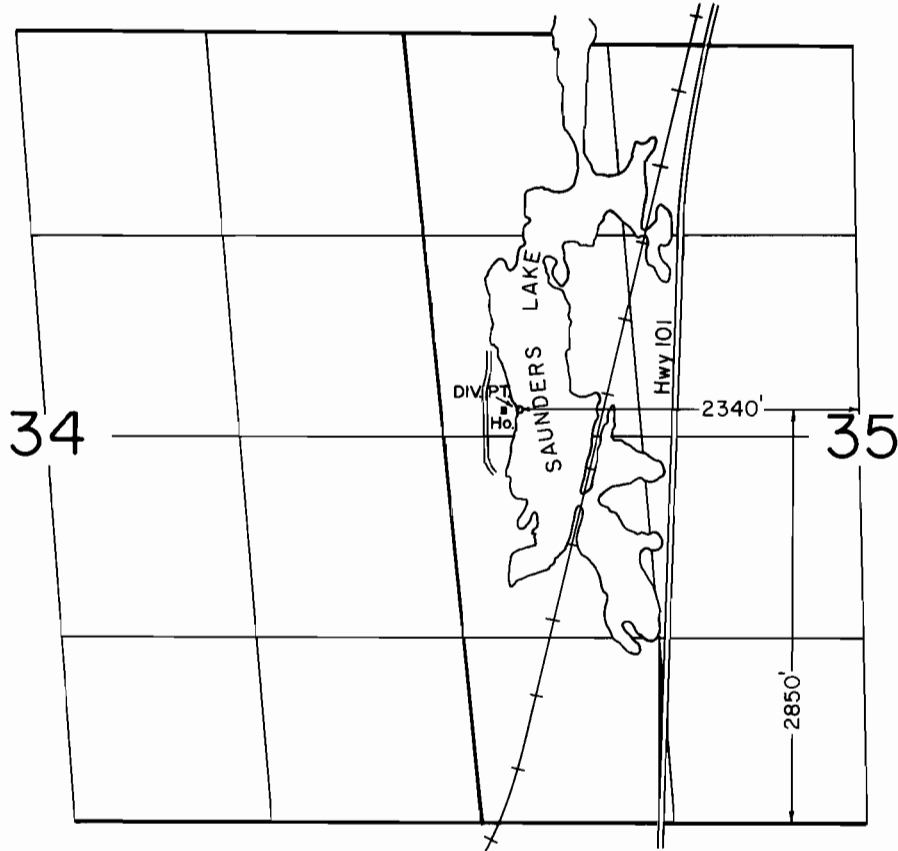

SCALE: 1" = 1320'

FINAL PROOF SURVEY
UNDER

Application No. 60154... Permit No. 45161.....
IN NAME OF

..... PAULA F. BRACKEN

Surveyed SEPT. 17, 1988, by V. L. CHURCH.....