




T.26 S., R.13 W., W.M.

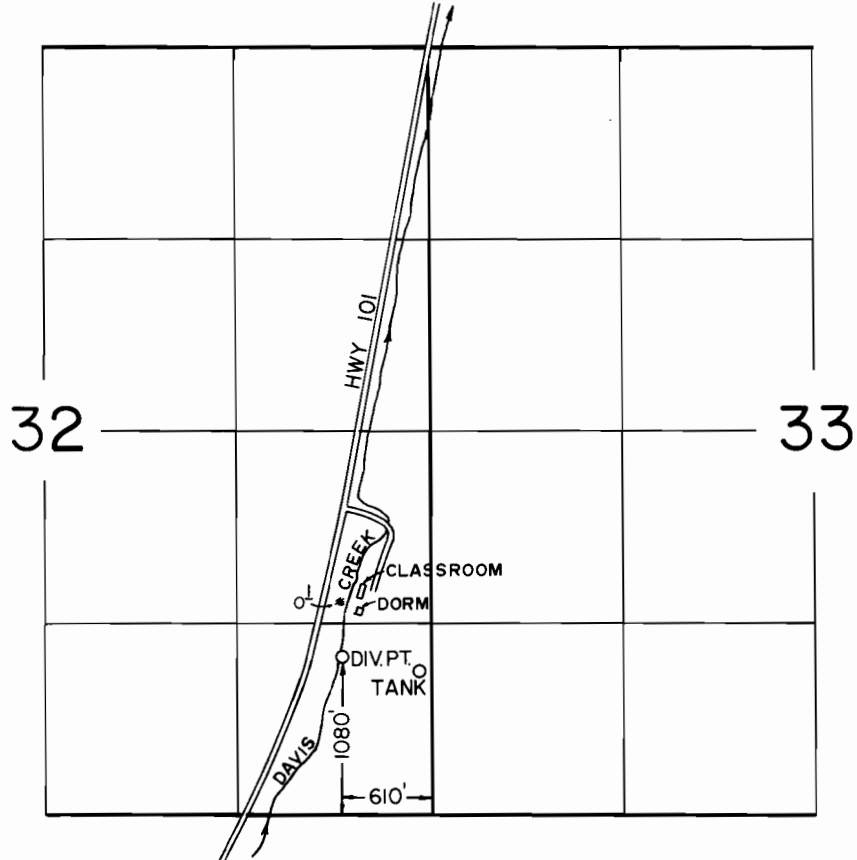

SCALE: 1" = 1320'

**FINAL PROOF SURVEY**  
UNDER

Application No. 60227... Permit No. 45166.....  
IN NAME OF

COOS COUNTY FOR BELLONI BOYS RANCH

Surveyed SEPT. 19. 1988., by J. R. KAUPPILA..