




T.24 & 25 S., R.12 W., W.M.

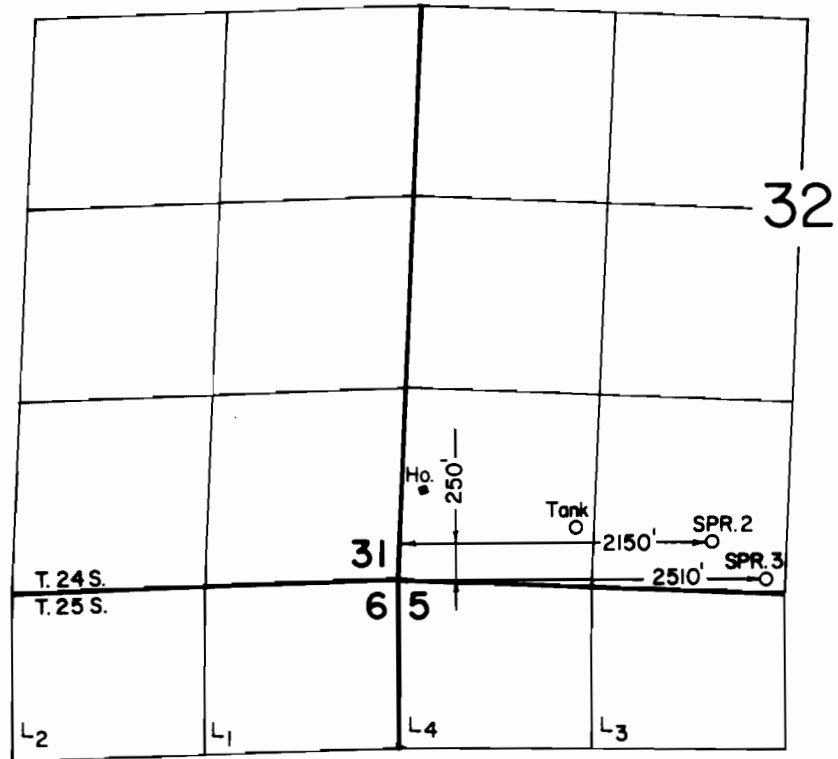

SCALE: 1" = 1320'

FINAL PROOF SURVEY UNDER

Application No. 60590... Permit No. 45179.....
IN NAME OF

GLEN F. & DOLORES M. COMPTON

Surveyed SEPT. 19 1988., by J. C. LARSON.....