




T. 23 S., R. 12 W., W.M.

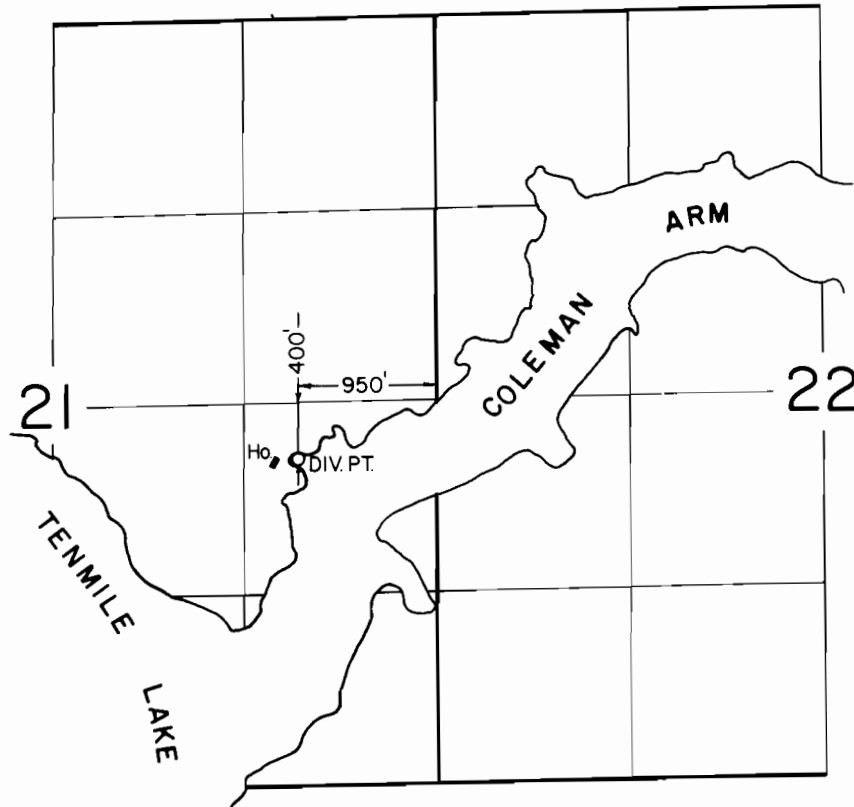

SCALE: 1" = 1320'

FINAL PROOF SURVEY
UNDER

Application No. 60838.. Permit No. 45416.....
IN NAME OF

...REX L. & EULA V. STUTZ.....

Surveyed SEPT. 21. 1988., by V. L. CHURCH.....