




T.28 S., R.11 W., W.M.

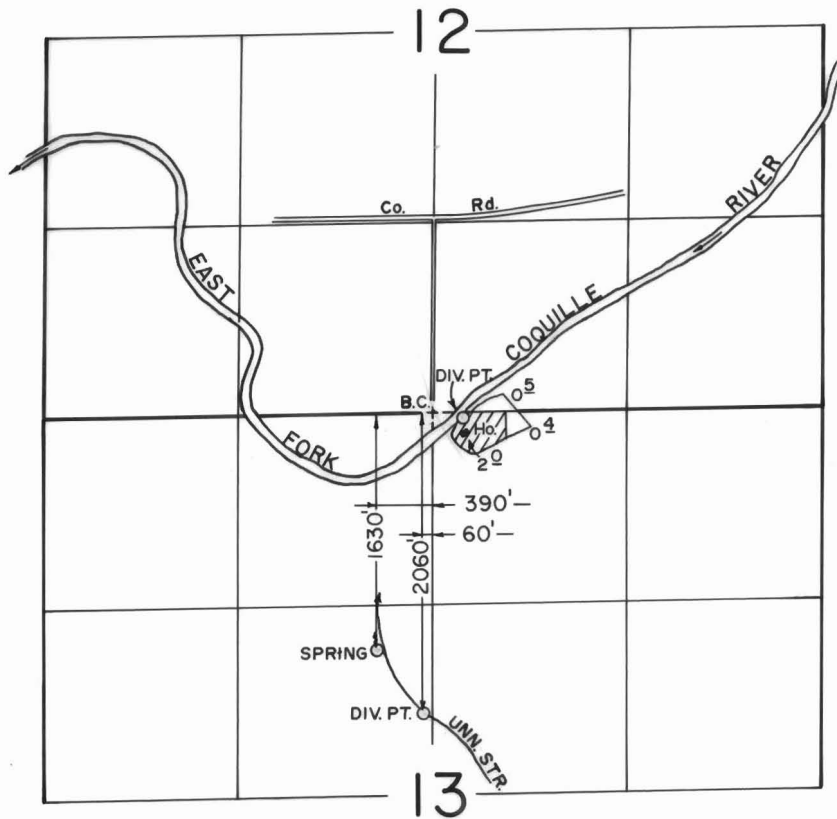

RIVER DIV.PT. LOC: 40'S. & 200'E. FROM N.1/4 CORNER SECTION 13

SCALE: 1" = 1320'

FINAL PROOF SURVEY
UNDER

Application No. 61298... Permit No. 46372...
IN NAME OF

WAYNE & LORENE PEARSON

Surveyed SEPT. 17, 1988, by B. S. JAMES