


T. 9 S., R. 6 W., W.M.

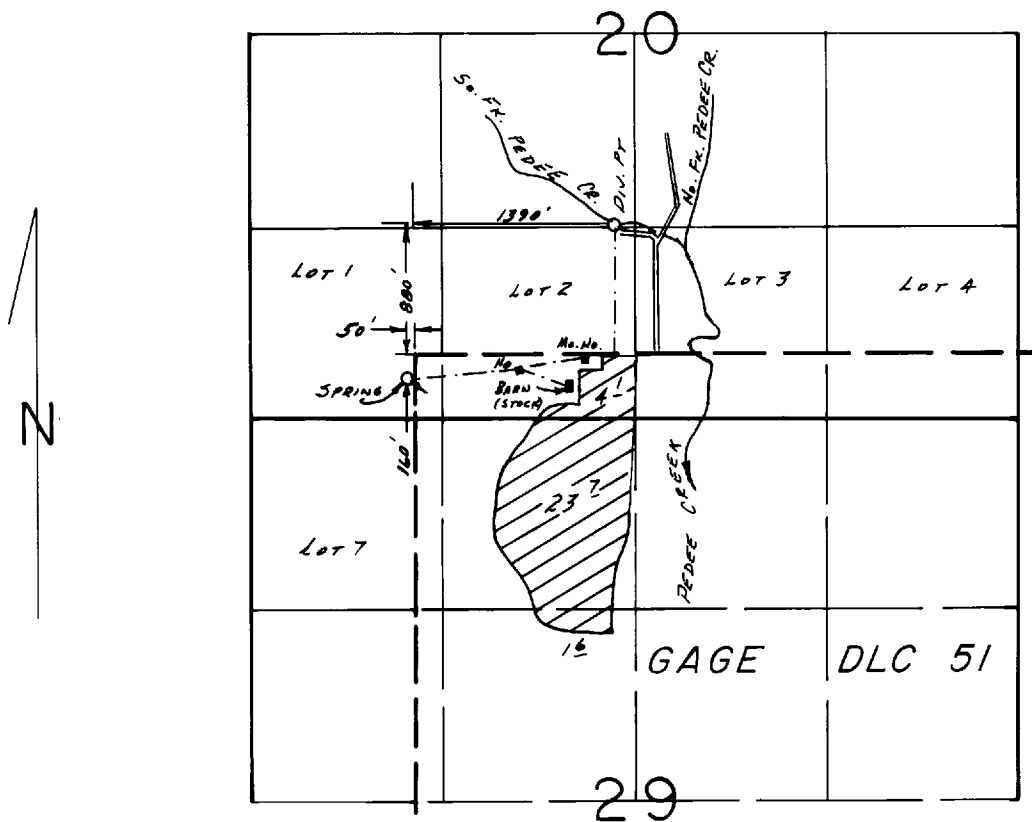

SCALE: 1" = 1320'

FINAL PROOF SURVEY
UNDER

Application No. 61304.. Permit No. 46373...
IN NAME OF

.....ARLENE L. KOVASH.....

Surveyed June 9, 1987, by B.W. BISHOP.....

3/27/89 *WLB*
41053-178-100R