




T. 24 S., R. 13 W., W.M.

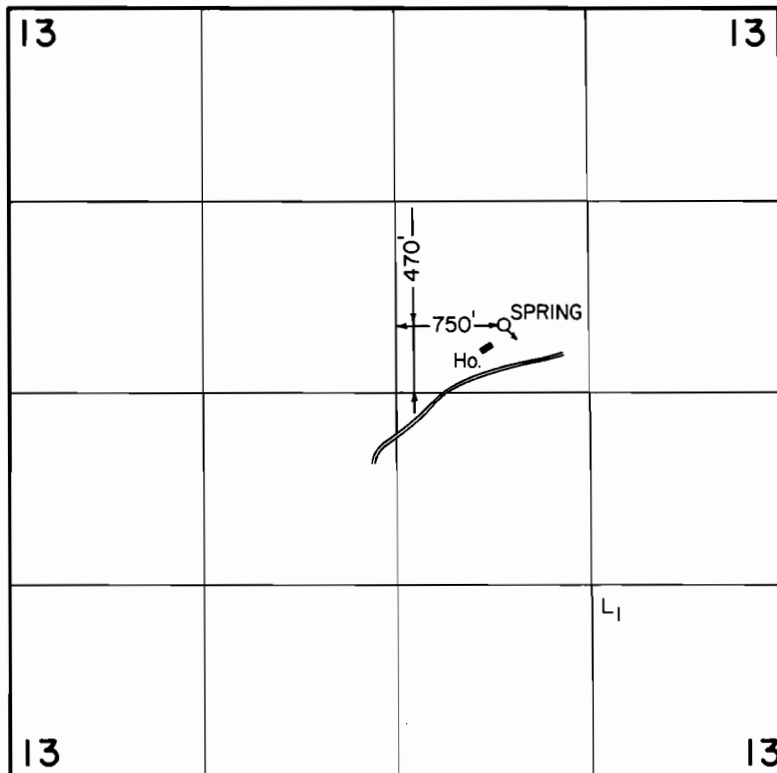

SCALE: 1" = 1320'

FINAL PROOF SURVEY
UNDER

Application No. 61306... Permit No. 46234.....
IN NAME OF

.....**BRYAN & WILMA CRAIG**.....

Surveyed SEPT. 19. 1988., by V. L. CHURCH.....