


T. 34 S., R. 2 W., W. M.

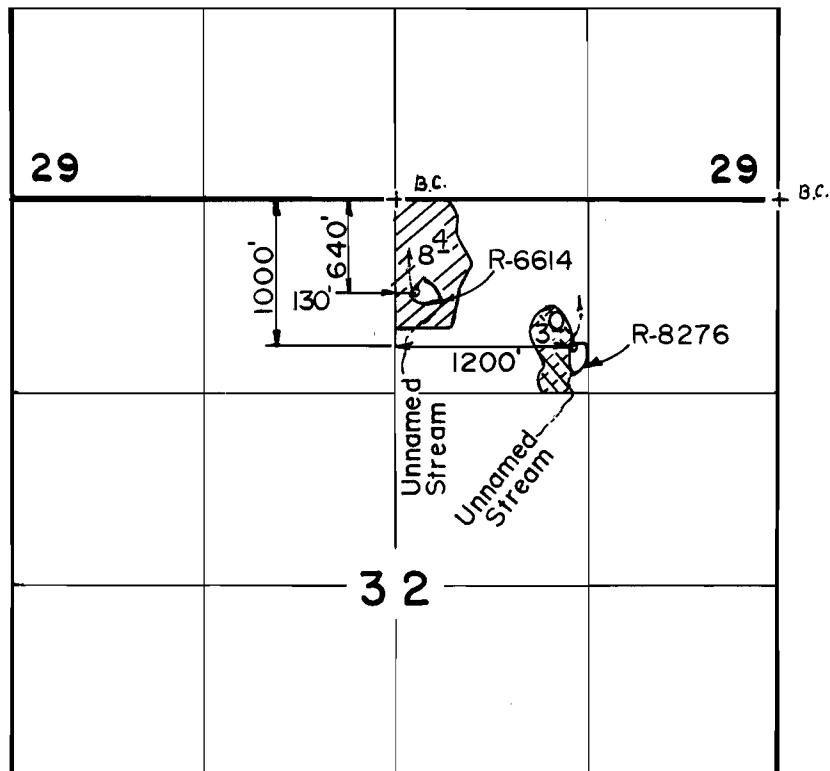

Scale: 1" = 1320'

FINAL PROOF SURVEY

UNDER

R-55380

R-6614

55381

41804

R-61681

R-8276

Application No. 61682... Permit No. 45808.....

IN NAME OF

.....ARNOLD W. SMITH.....

Surveyed JUN...16.. 19.87., by B...S...JAMES...