


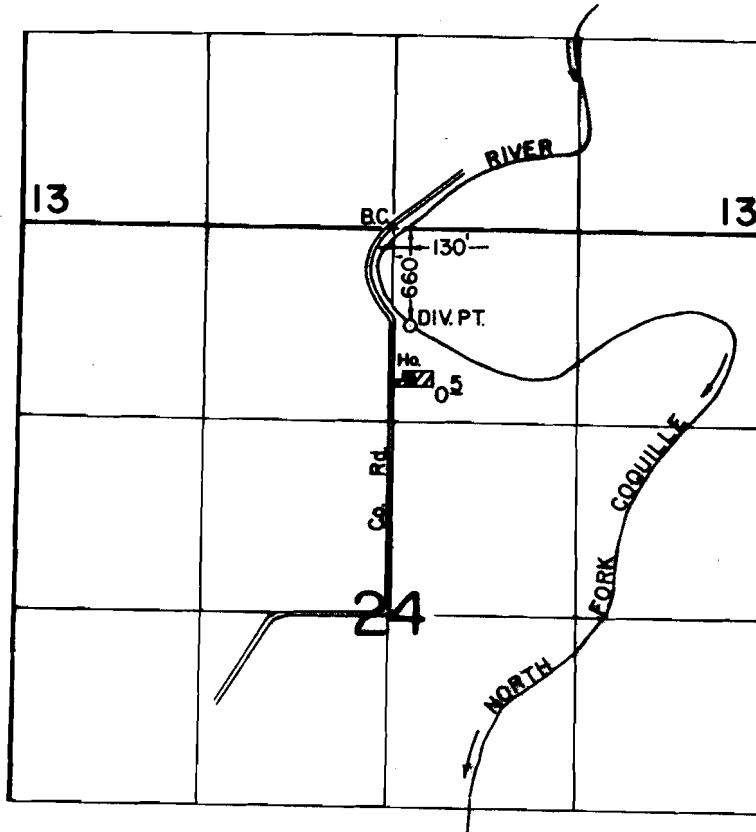

T.27S.,R.12W.,W.M.



SCALE: 1" = 1320'

FINAL PROOF SURVEY
UNDER

Application No. 62201... Permit No. 46404...
IN NAME OF

..... PAULINE G. WHEREAT

Surveyed SEPT. 20 1988, by Z. F. SALEH.....